


T. 11 S. R. 3 W. W. M.

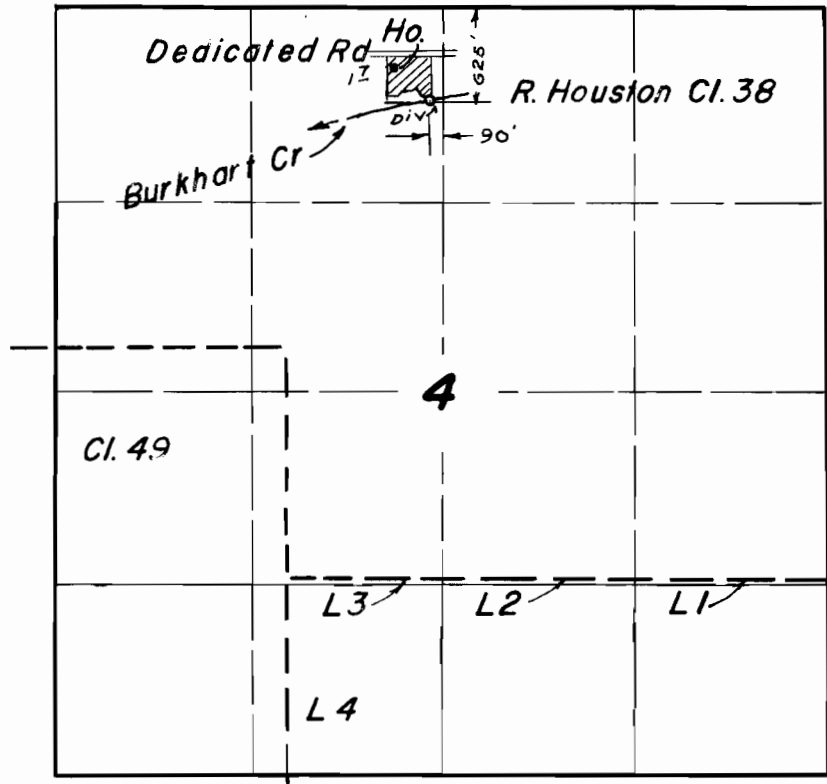

FINAL PROOF SURVEY  
UNDER

Application No. 37875 Permit No. 28227  
IN NAME OF

**Cecil J. Burkhart**

Surveyed June 16 1965, by F. Siegmund