


T.18S.R.47E.W.M.

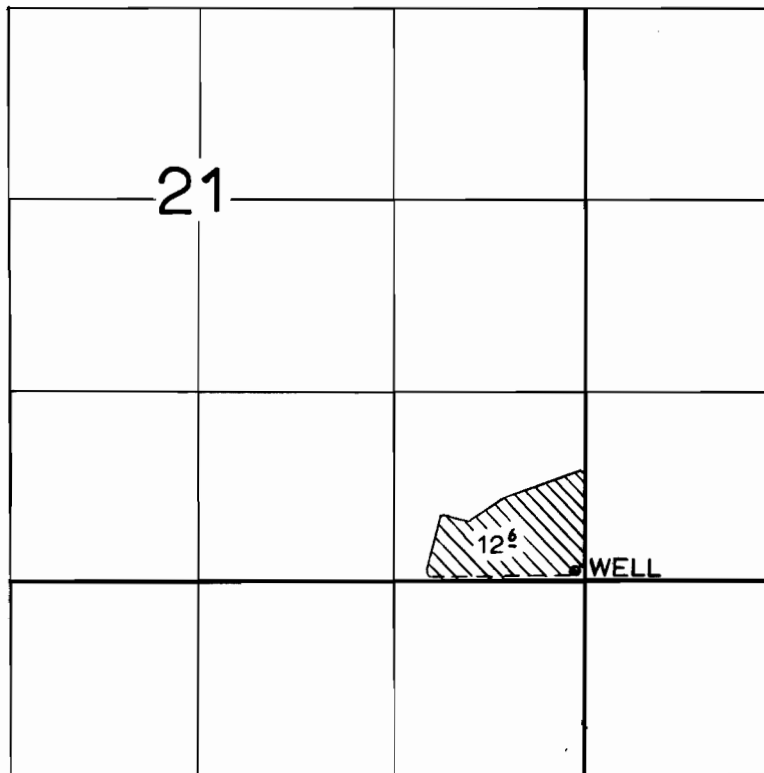

FINAL PROOF SURVEY
UNDER

Application No. G-2660 Permit No. G-2466
IN NAME OF

W. J. WEESE

Surveyed OCT. 8, 1964, by F. M. E. B. R. I. N. G.