


T.21S.R.46E.W.M:

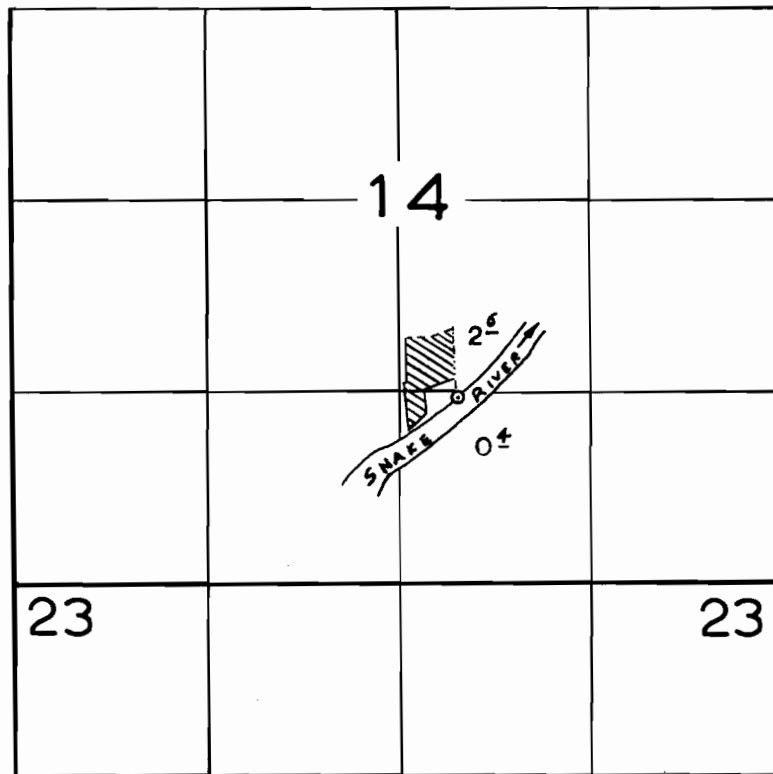

FINAL PROOF SURVEY
UNDER

Application No. 33937... Permit No. 27184....

IN NAME OF

HARVEY R. OTIS

Surveyed NOV. 12... 1964., by *E.W. ELKING*.....