


T. 7S. R. 2 W. W.M.

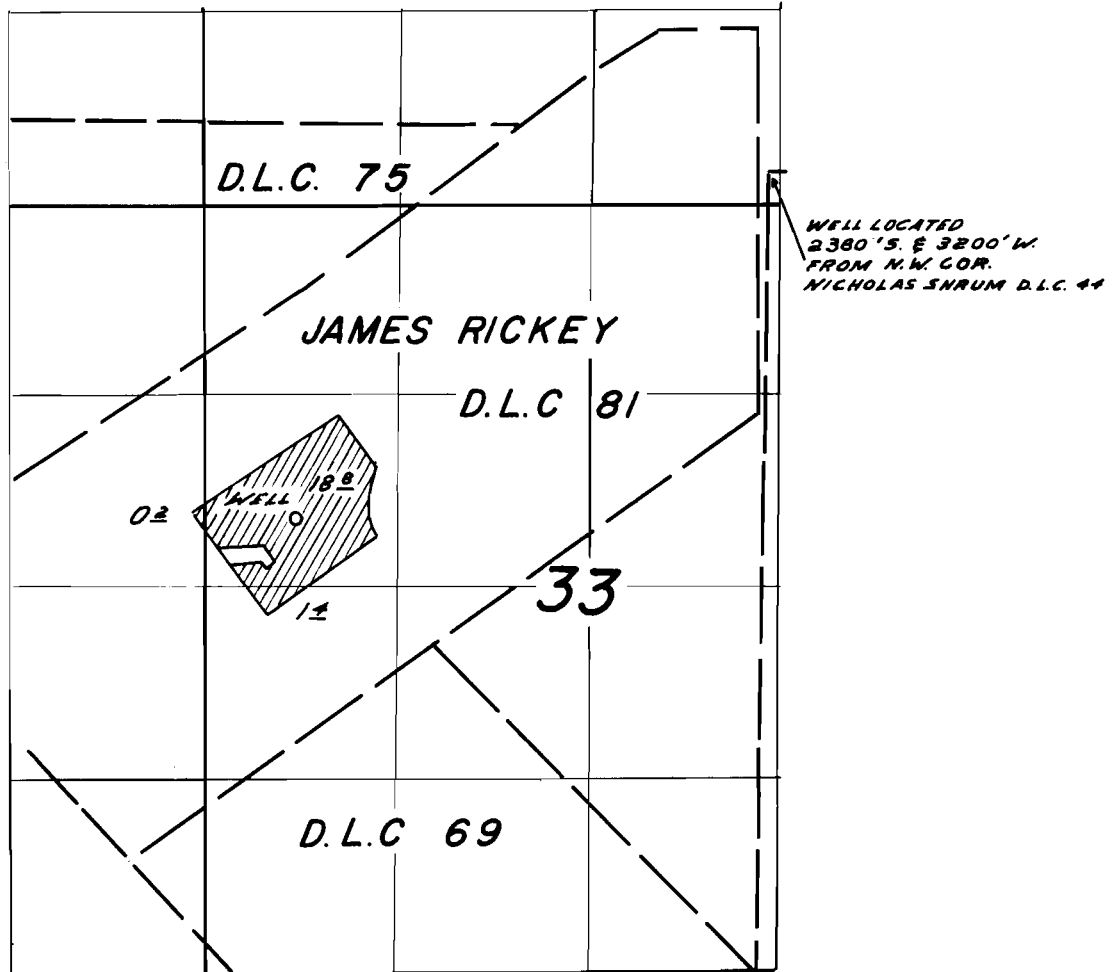

FINAL PROOF SURVEY
UNDER

Application No. G-1588 Permit No. G-1459
IN NAME OF

CHARLES R. FISCHER

Surveyed APR. 13, 1965, by L. COLEBANK