


T.6S. R.1W. W.M. .

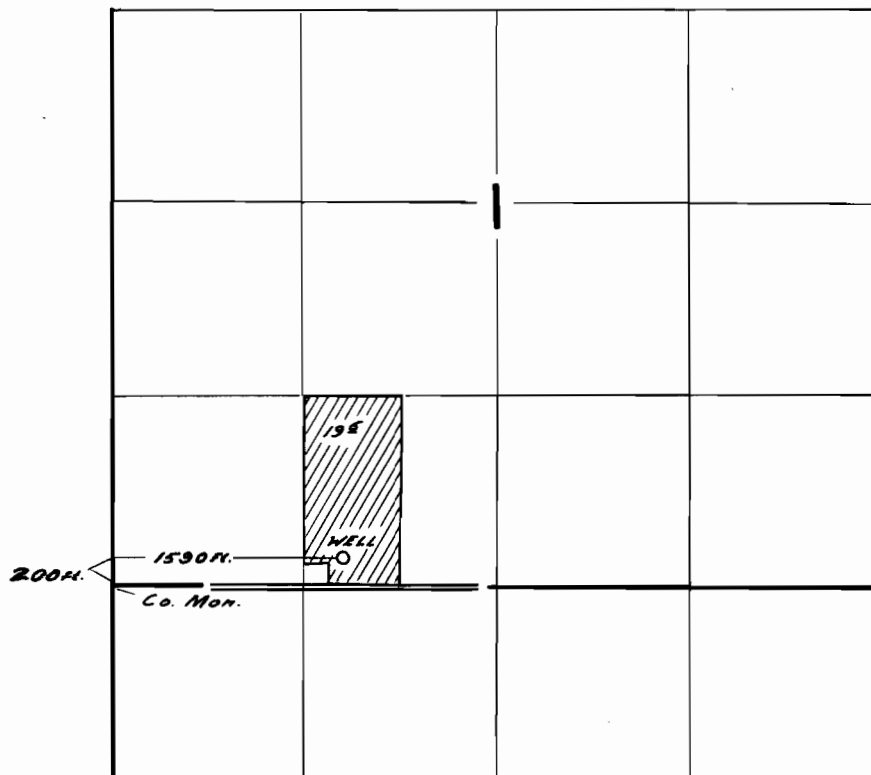

FINAL PROOF SURVEY
UNDER

Application No. G-2262 Permit No. G-2078
IN NAME OF

RAYMOND KNORI

Surveyed JUNE 3 1965, by L. COLEBANK