


T.5&6S.R.3W.W.M.

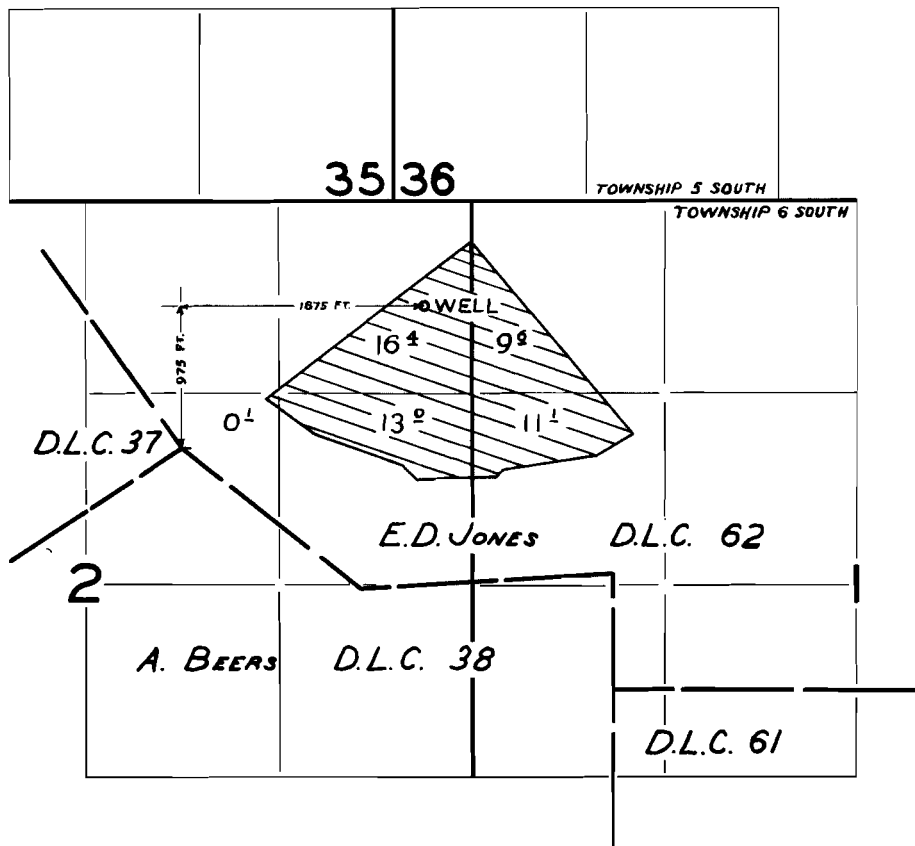

**FINAL PROOF SURVEY**  
UNDER

Application No. G-2960 Permit No. G-2753  
IN NAME OF

JOE & RUTH RYAN

Surveyed JUL 8 1965, by L. COLEBANK