


T.6S.R.1E.W.M.

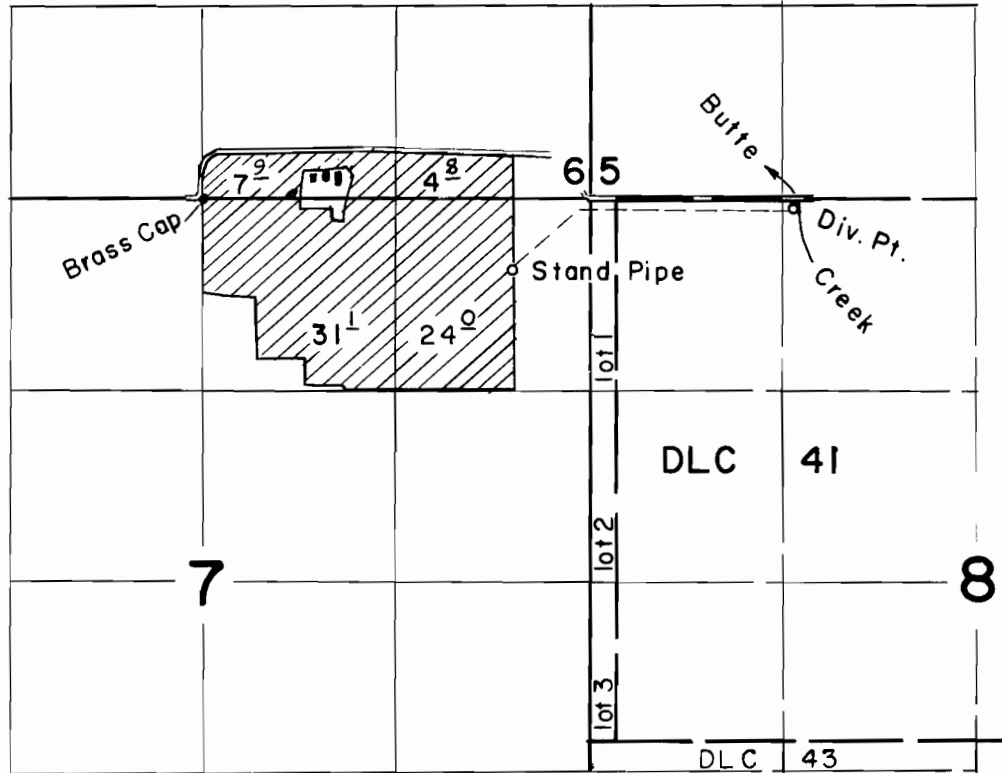

FINAL PROOF SURVEY UNDER

Application No. 34604 Permit No. 27172
IN NAME OF

Edward & Vernos Gath

Surveyed Sept. 30 1964, by F. Siegmund