


T.6S. R.I.E. W.M

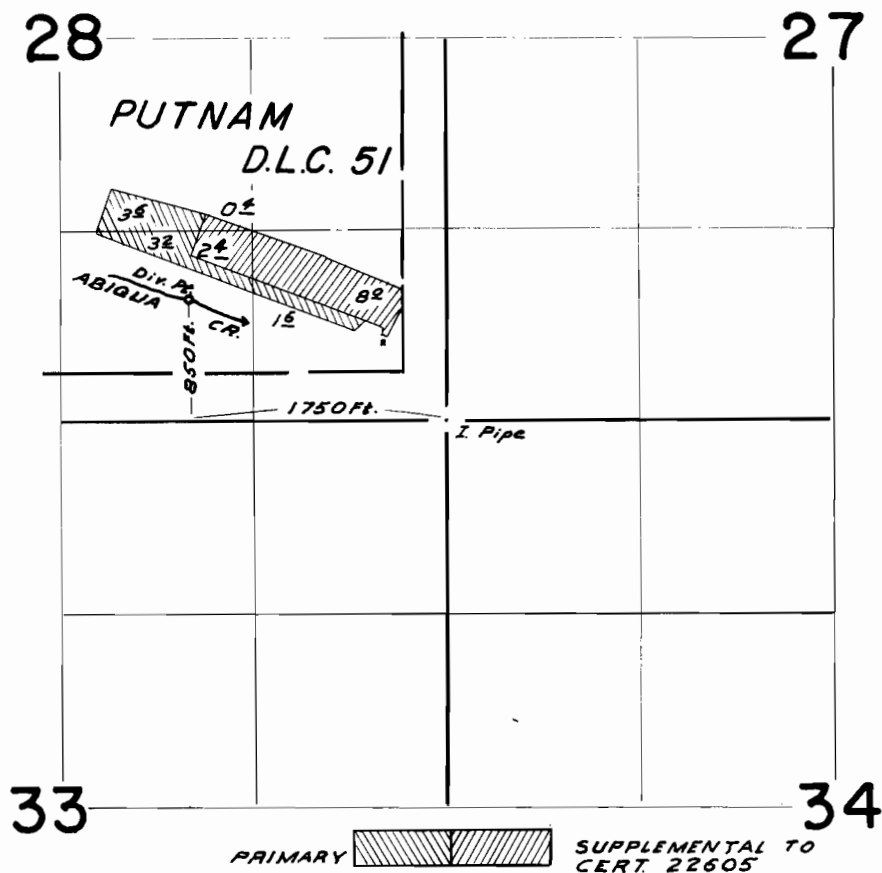

FINAL PROOF SURVEY  
UNDER

Application No. 34637 Permit No. 27207  
IN NAME OF

THOMAS A. HARTLEY

Surveyed MAY 11 1965, by L. COLEBANK