


T.7S. R.IW. W.M.

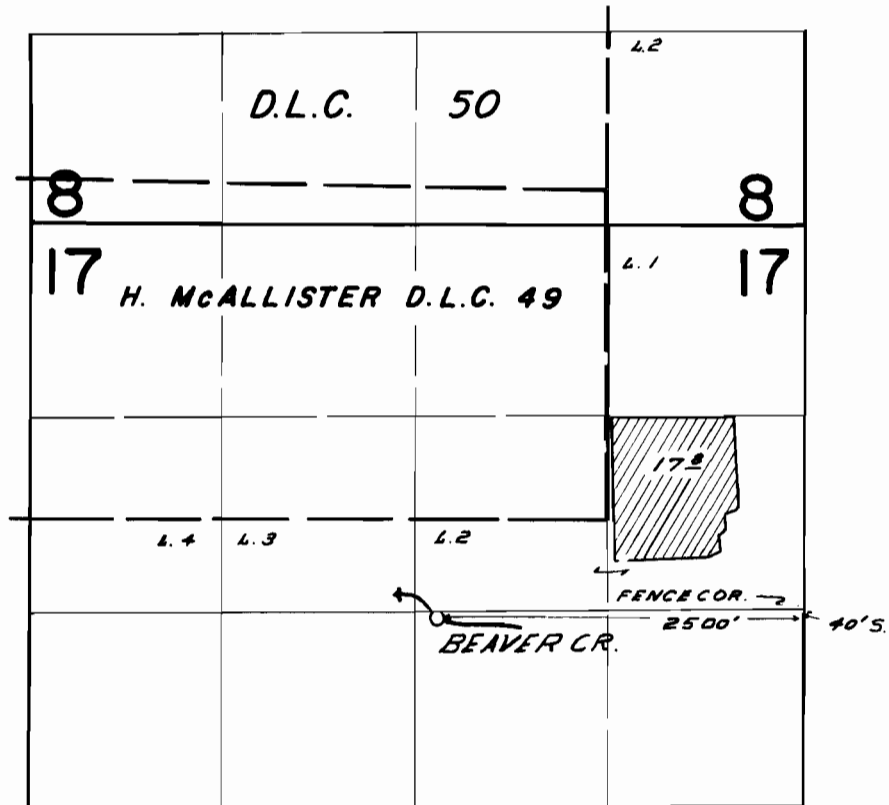

FINAL PROOF SURVEY
UNDER

Application No. 34829 Permit No. 27347
IN NAME OF

EDWARD KUENZI

Surveyed APR 14 1965, by L. COLEBANK