


T.6S. R.1E. W.M.

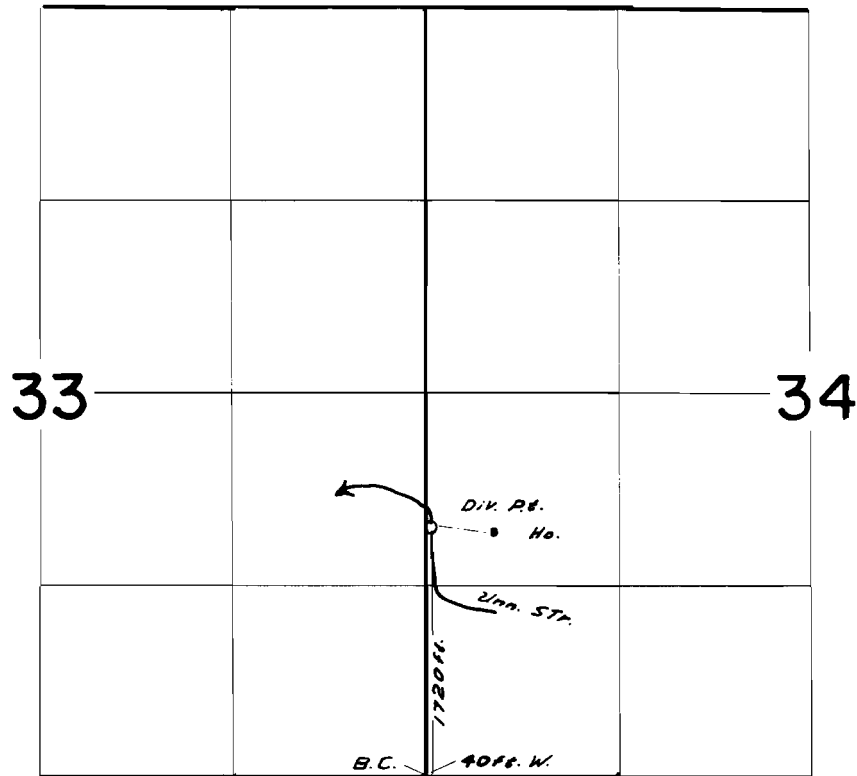

FINAL PROOF SURVEY
UNDER

Application No. 39719 Permit No. 29549
IN NAME OF

ROMA C. RAMSBY

Surveyed MAY 10 19 65, by L. COLEBANK