


T. 7 S. R. 1 W. W.M.

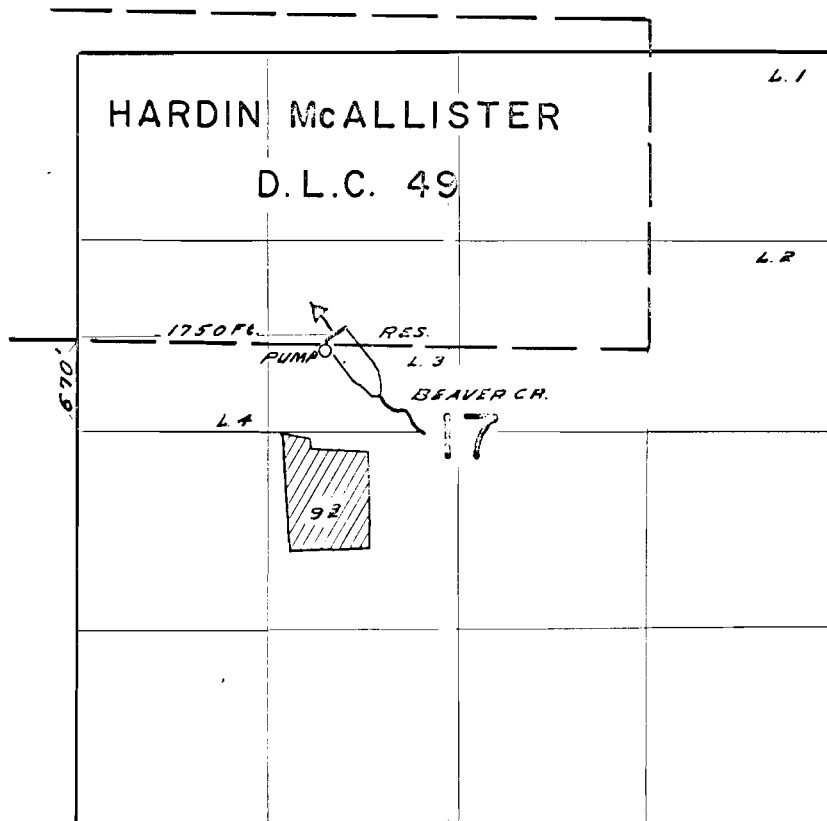

FINAL PROOF SURVEY
UNDER

R - 40311 R - 4301

Application No. 40000 Permit No. 29042
IN NAME OF

..... PAUL STAEDLI

Surveyed APR. 20. 1965, by L. COLEBANK