


T. 7 S. R. 1 W. W.M.

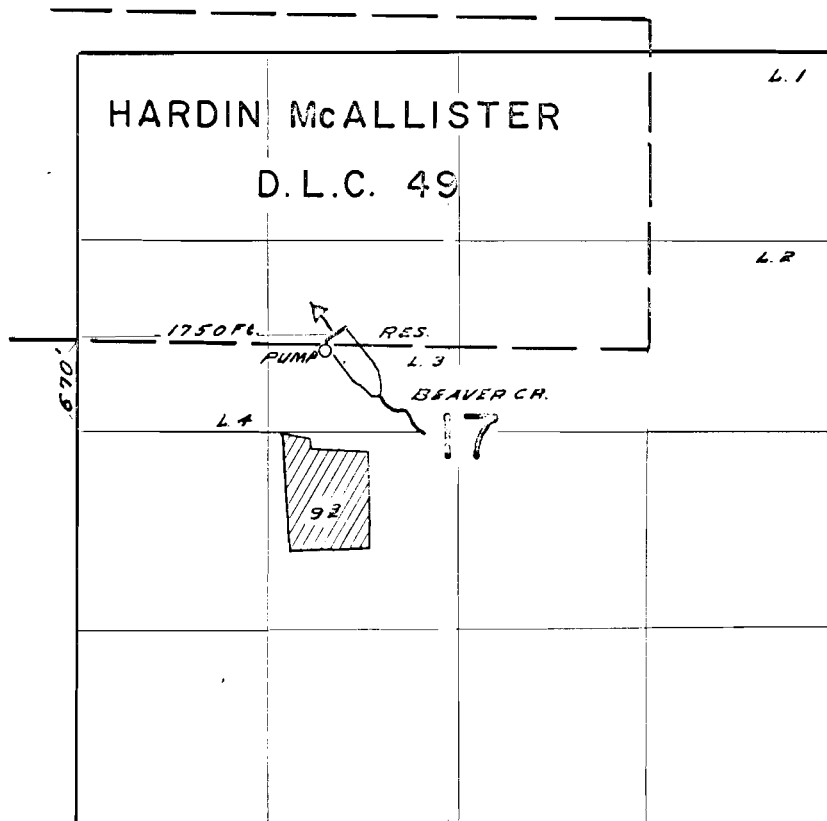

**FINAL PROOF SURVEY**  
UNDER

R - 40311                      R - 4361

Application No. 40000 Permit No. 29942  
IN NAME OF

..... PAUL ..... STAEDLI .....

Surveyed APR. 20. 1965, by L. COLEBANK