


T. I. S. R. 4 E. W. M.

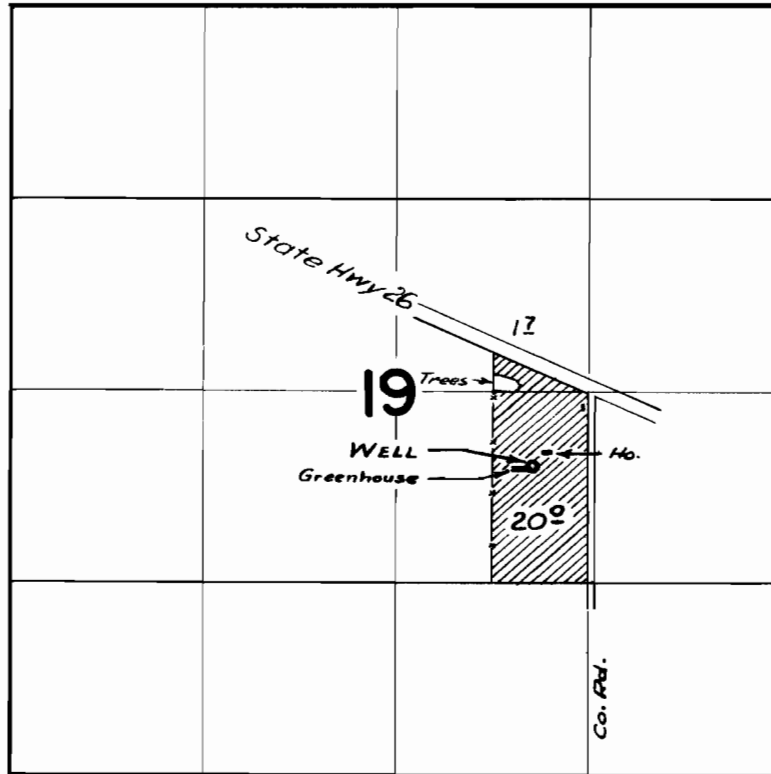

FINAL PROOF SURVEY
UNDER

Application No. G-1743 Permit No. G-1594
IN NAME OF

ARTHUR J. SUHR

Surveyed 14 Oct. 1964, by M. Bish