


T.9S.R.5W.W.M.

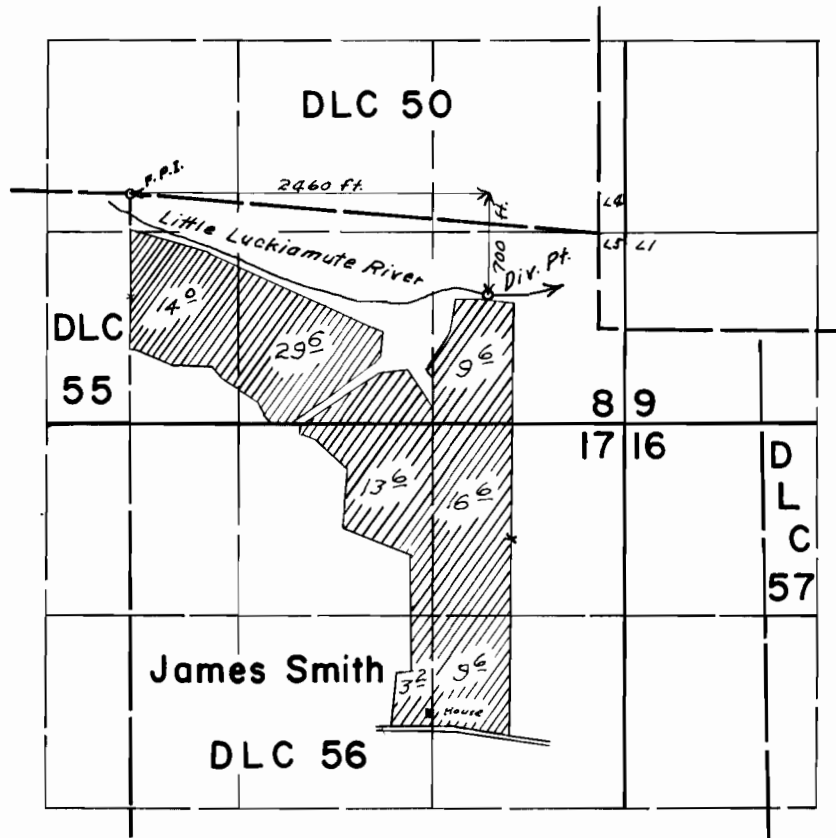

FINAL PROOF SURVEY UNDER

Application No. 35212 ... Permit No. 27546...
IN NAME OF

MATTIE JANE OSBORN

Surveyed August 17, 1965, by *Clayton J. Gardner*