


T. I. S. R. 8 W. W. M.

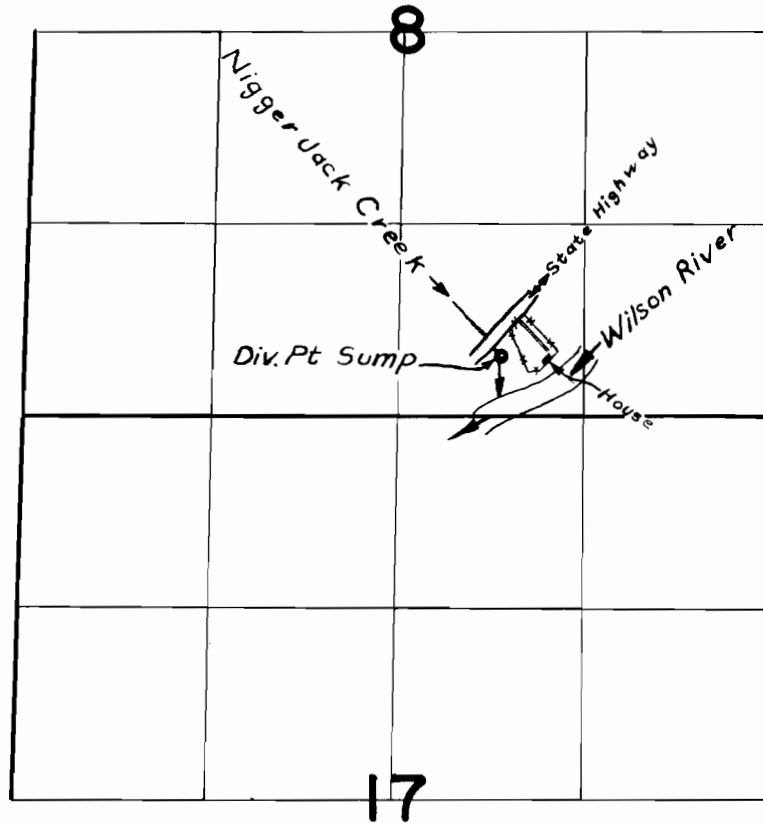

FINAL PROOF SURVEY UNDER

Application No. 34051 Permit No. 26873
IN NAME OF

ROBERT L. STOPPER, JR.

Surveyed May 11 1965, by M. Bish

1965-1A

S. L. Jr.