


# T. 2N. R. 10W. W.M.

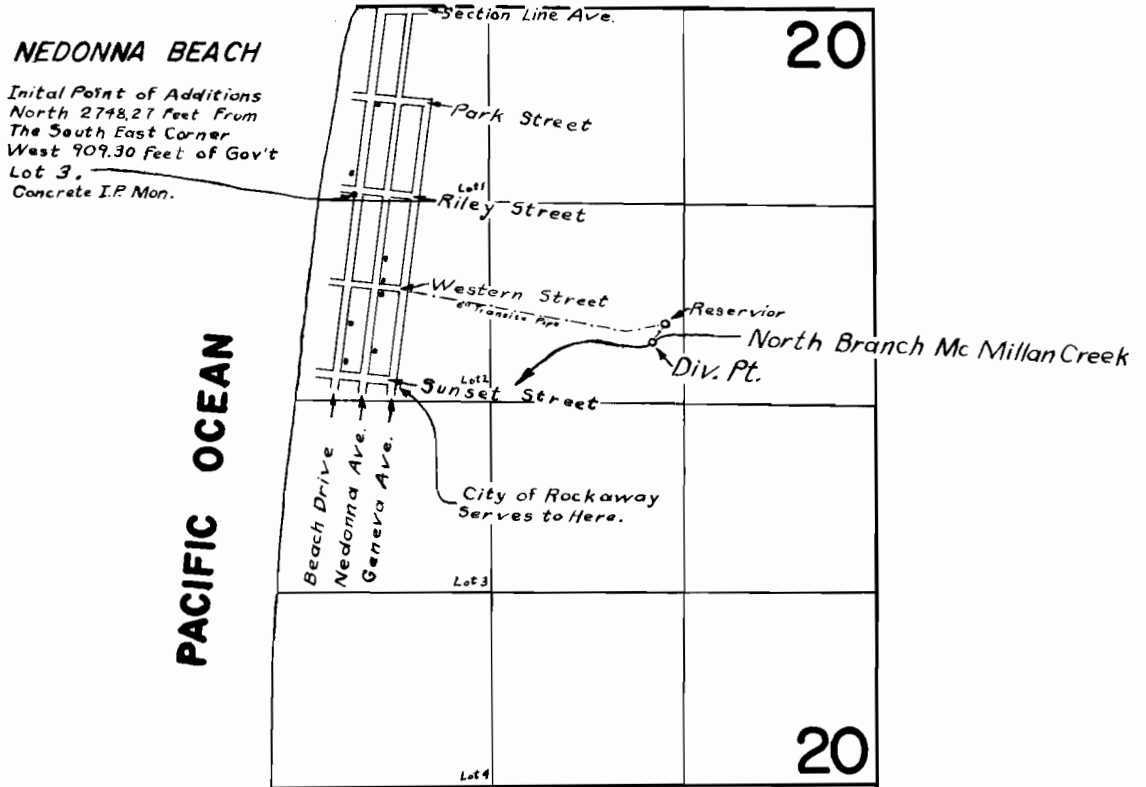

## FINAL PROOF SURVEY UNDER

Application No. 34645 Permit No. 27215  
IN NAME OF

H. ROBERT RILEY

Surveyed June 11 1964, by M. Bish