


T. I. S. R. 9 W. W. M.

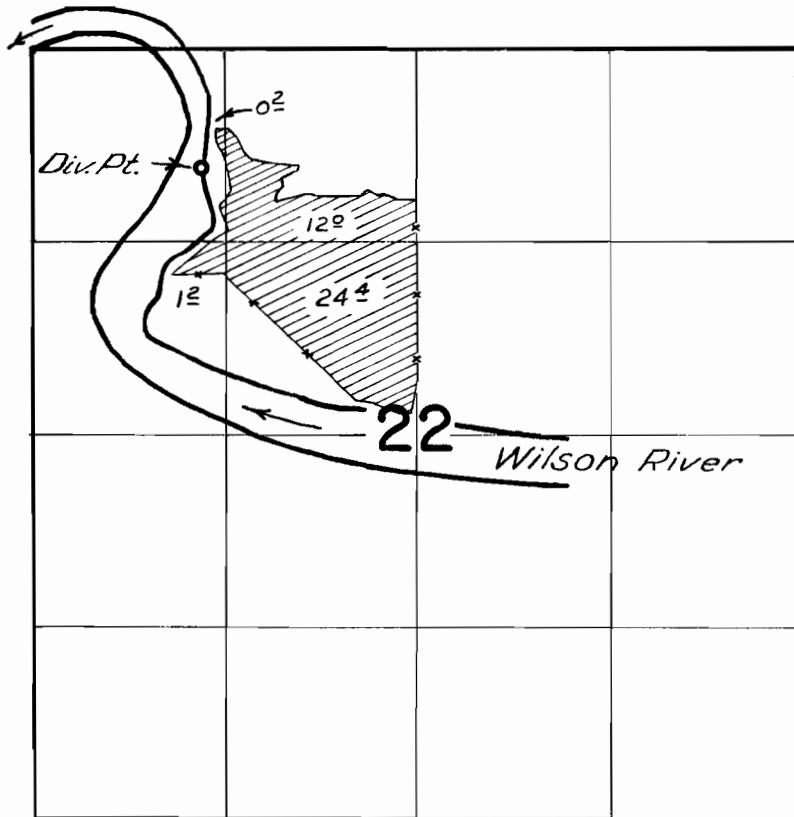

FINAL PROOF SURVEY UNDER

Application No. 35601 Permit No. 27503
IN NAME OF

HARLEY CHRISTENSEN

Surveyed JULY 31, 1963, by C. BAKER