


T.5S. R.11W. W.M.

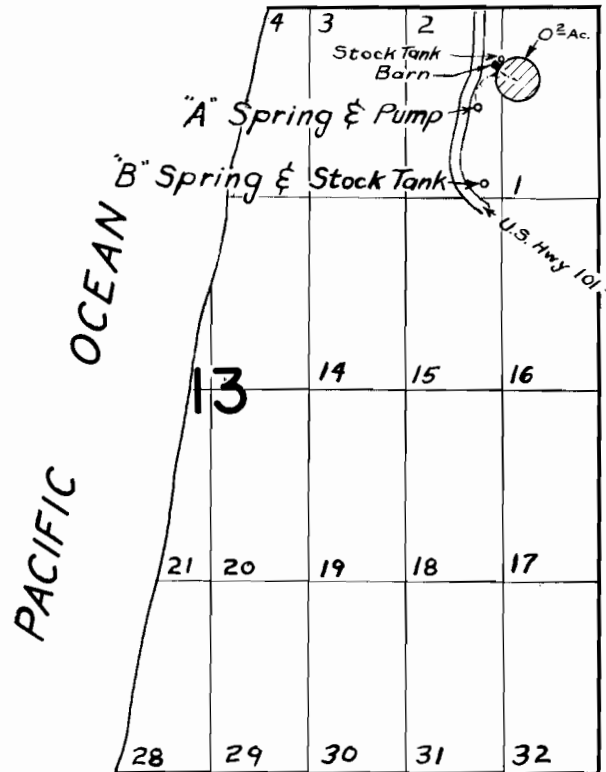

FINAL PROOF SURVEY UNDER

Application No. 37402 Permit No. 27933
IN NAME OF

WILLIAM F. MORSE

Surveyed June 10, 1964, by M. BISH