


Final Proof by Insp. Basin

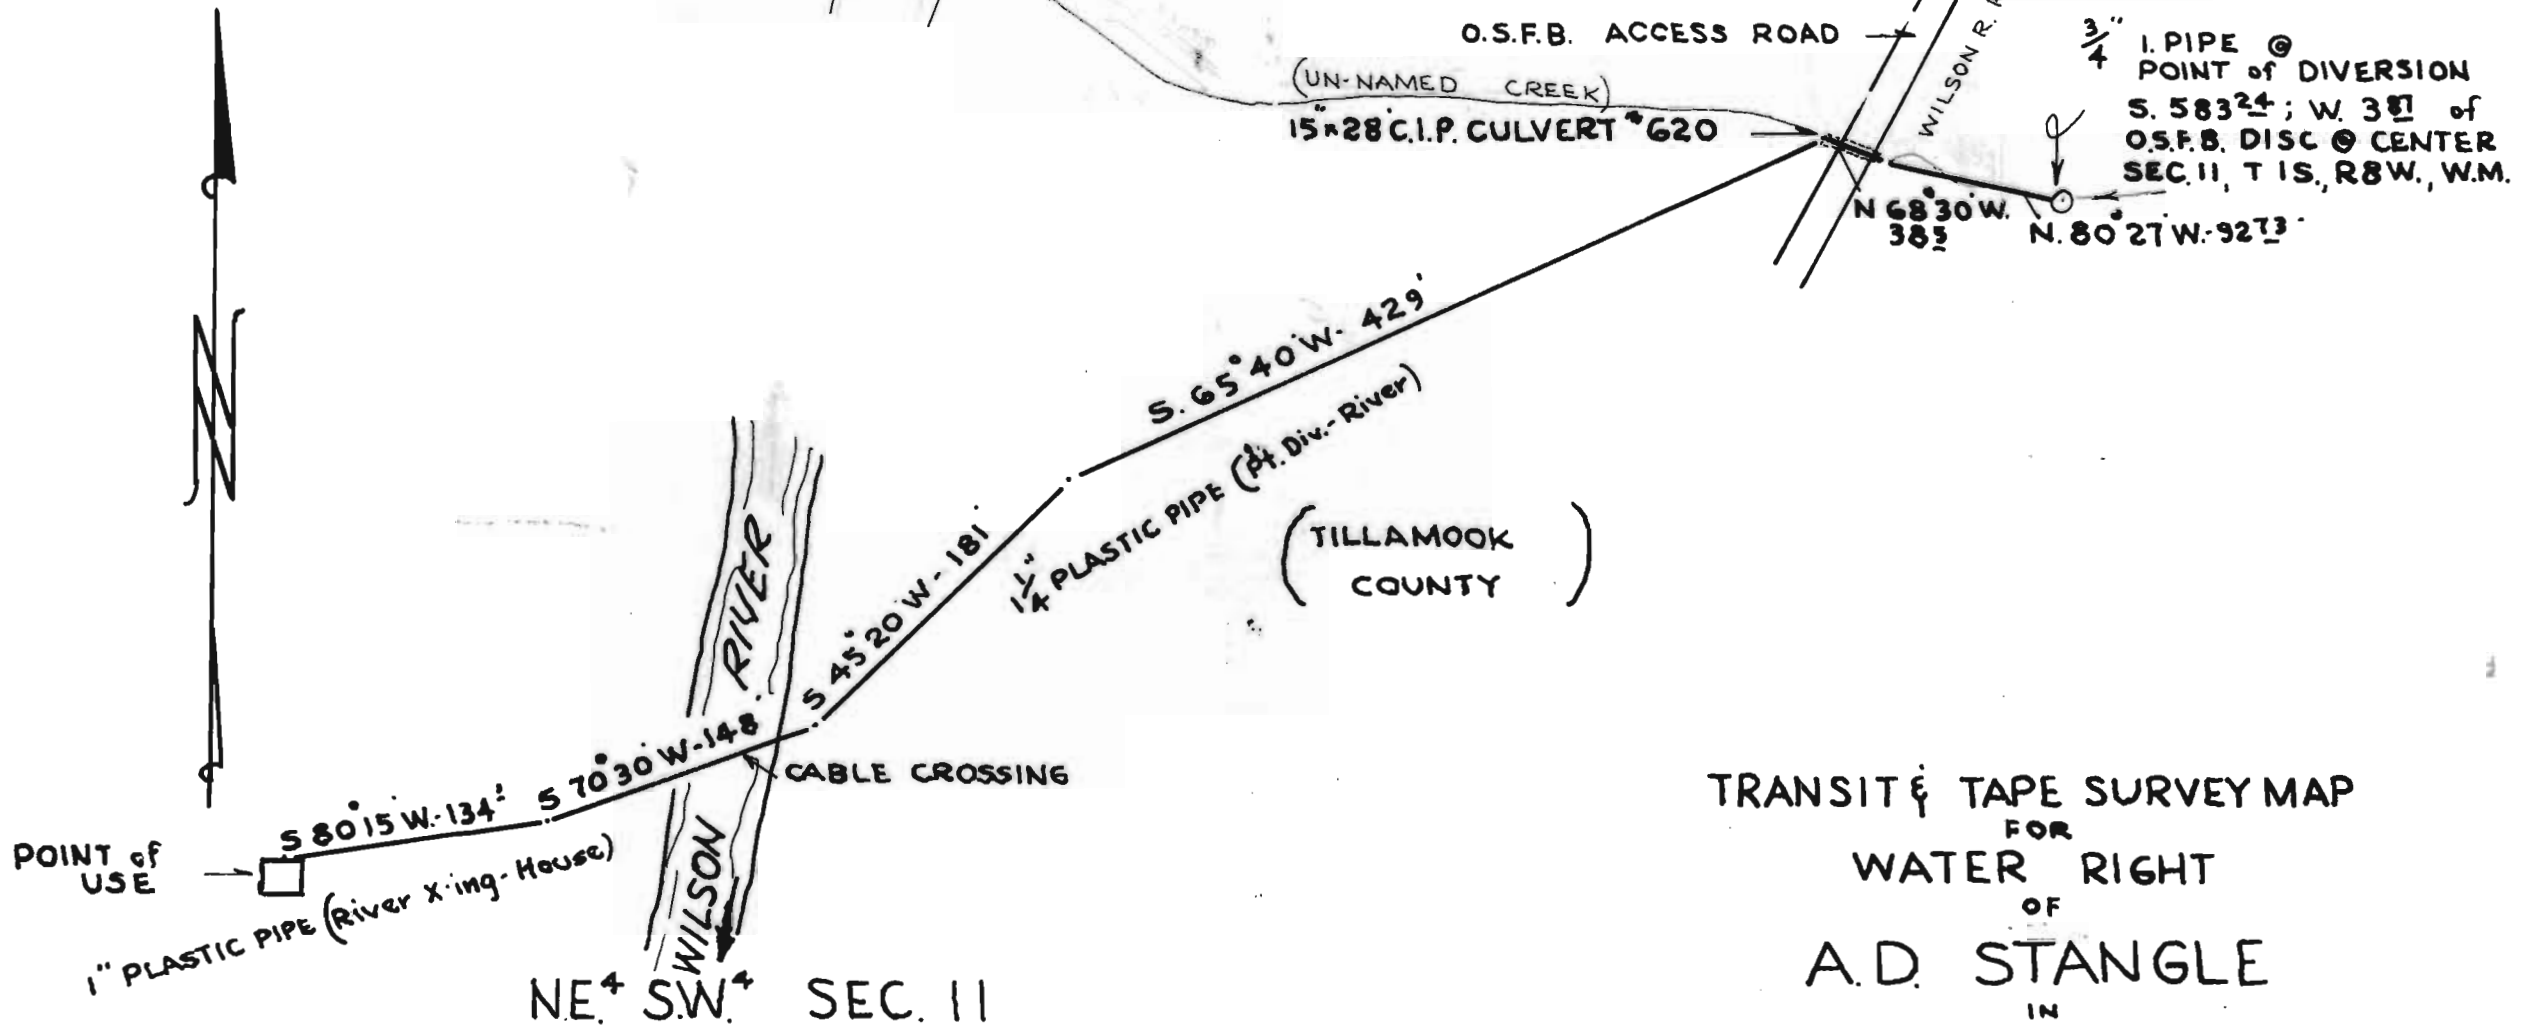

TRANSIT & TAPE SURVEY MAP
 FOR
 WATER RIGHT
 OF
 A.D. STANGLE
 IN
 SECTION II, T. 15, R. 8W., W.M.
 1962

SCALE 1" = 100 Feet.

NOTE: Meridian from O.S.H. map tangent @
 O.S.H. sta. 606+06^S - 636+68^L

REGISTERED
 OREGON
 LAND SURVEYOR
John L. Carllich
 MAY 9, 1952
 JOHN L. CARLICH
 287

JAN 1 1963

Application No. 38339
 Permit No. 28537