


# T.2S.R.9W.W.M.

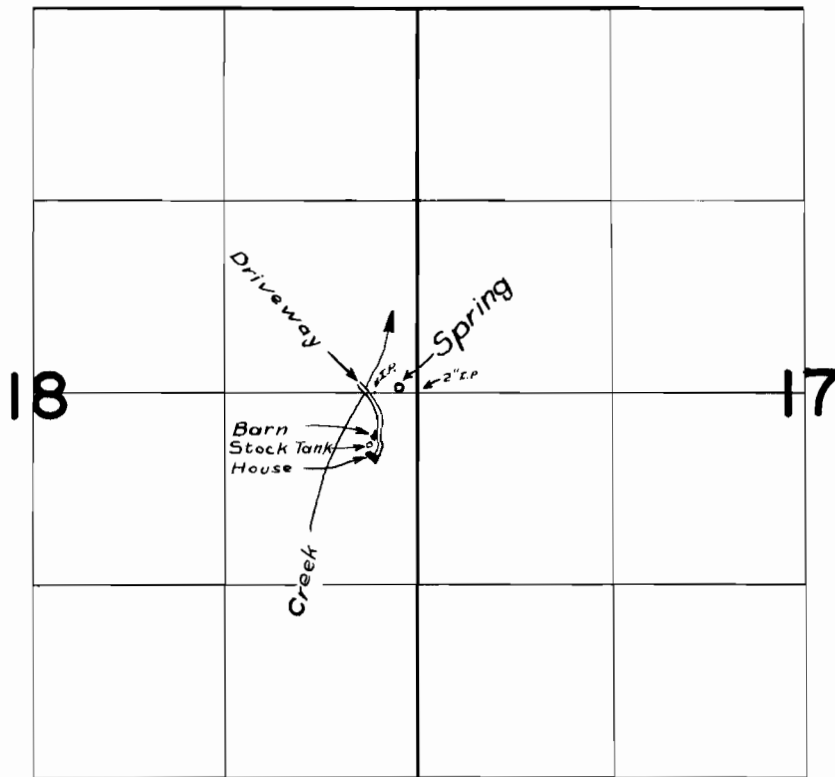

## FINAL PROOF SURVEY UNDER

Application No. 39831 Permit No. 29653  
IN NAME OF

KENNETH SEEGER

Surveyed May 13 1965, by M. Bish