


T.6N. R.34E. W.M.

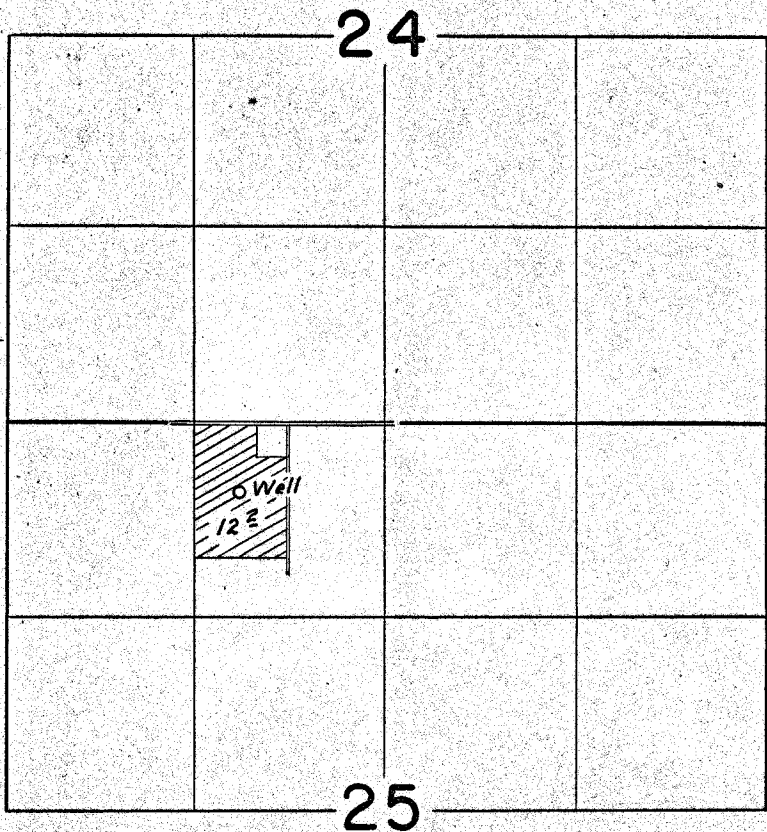

FINAL PROOF SURVEY UNDER

Application No. G-2302... Permit No. G-2122...
IN NAME OF

BEATRICE and ERNEST R. JORDAN

Surveyed April 22, 1964, by R. Jackson.....