


T.6N.R.35E.W.M.

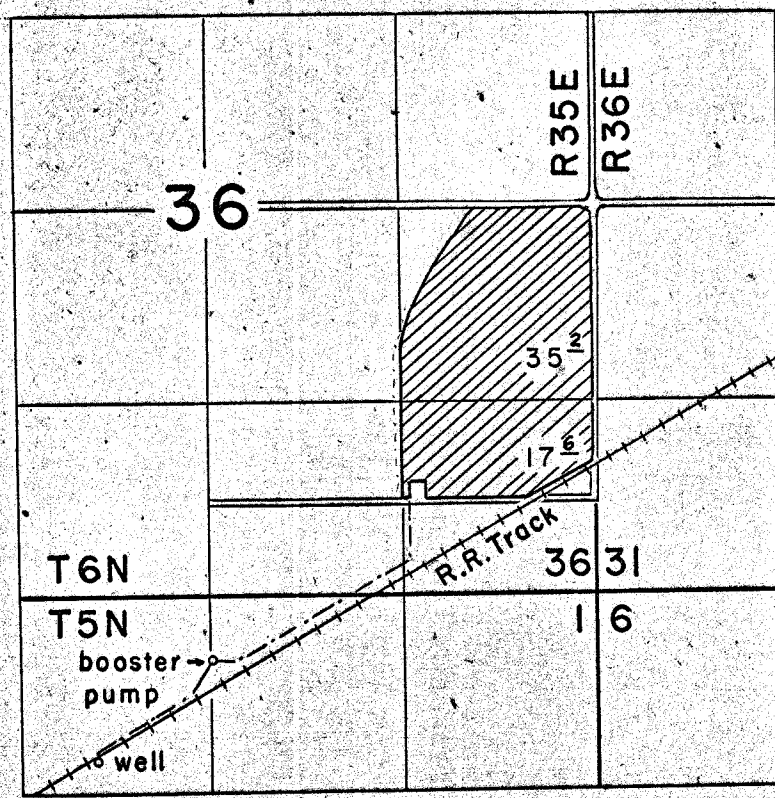

FINAL PROOF SURVEY UNDER

Application No. G-2645. Permit No. G-2543.

IN NAME OF

Sam LeFore

Surveyed Aug. 25 1964, by C.J. Gardner