


T.3S.R.38E.W.M.

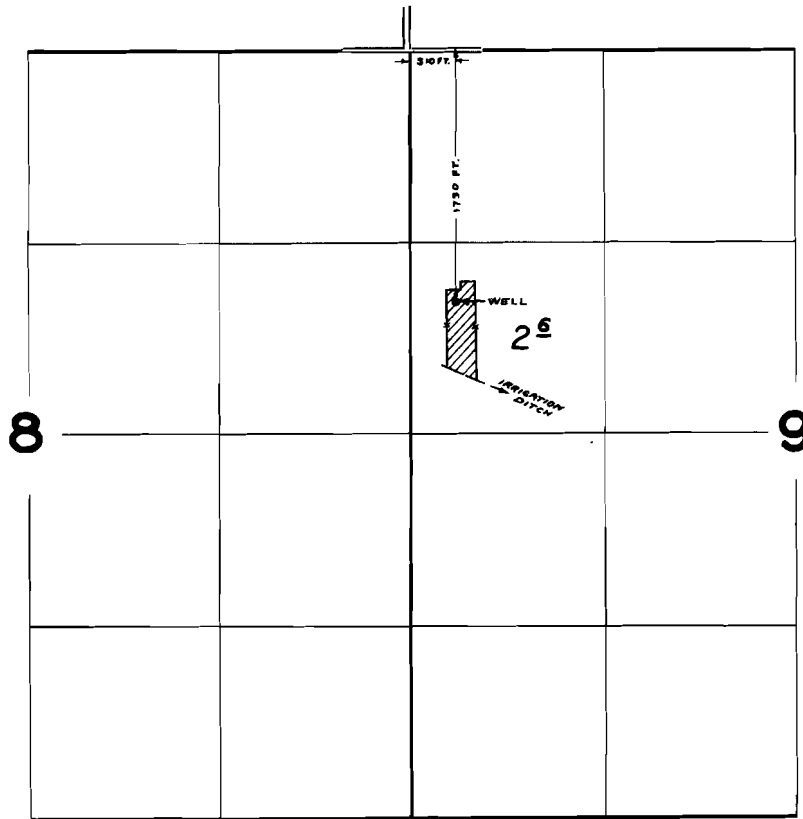

FINAL PROOF SURVEY UNDER

Application No. G-2864 Permit No. G-2665
IN NAME OF

HAROLD SCHWEBKE

Surveyed Nov. 2 1965, by C. GARDNER