


**RECEIVED**  
MAR - 8 1965  
STATE ENGINEER  
SALEM OREGON

T. 5S. R. 13E.W.M.

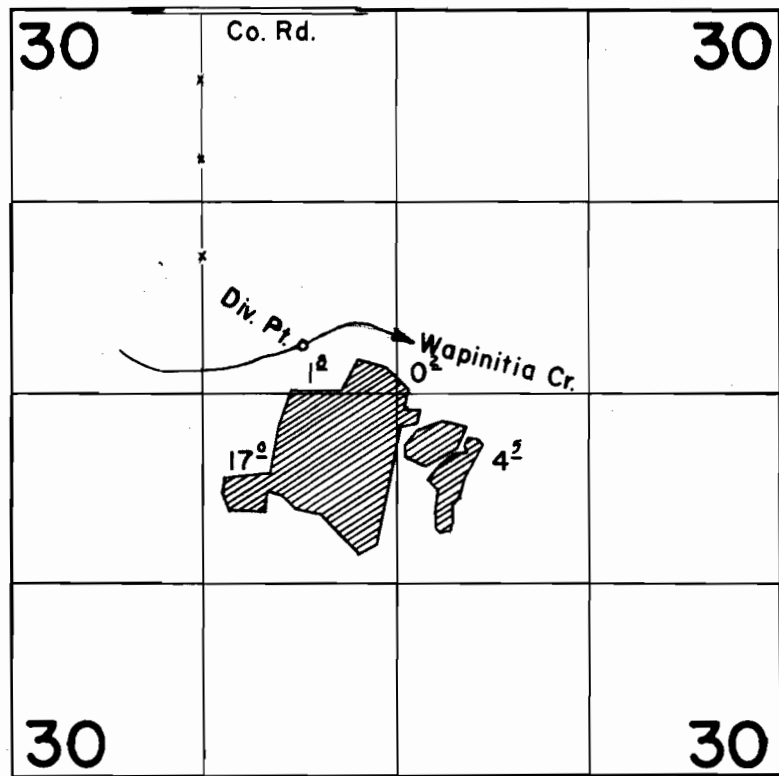

**FINAL PROOF SURVEY**  
UNDER

Application No. 33151..... Permit No. 26212.....  
IN NAME OF

..... LYLE L. GABLE .....

Surveyed June 10, 1964, by *Larry W. Gebousek*  
March 1, 1965