


T.I.S.R.I.W.W.M.

18

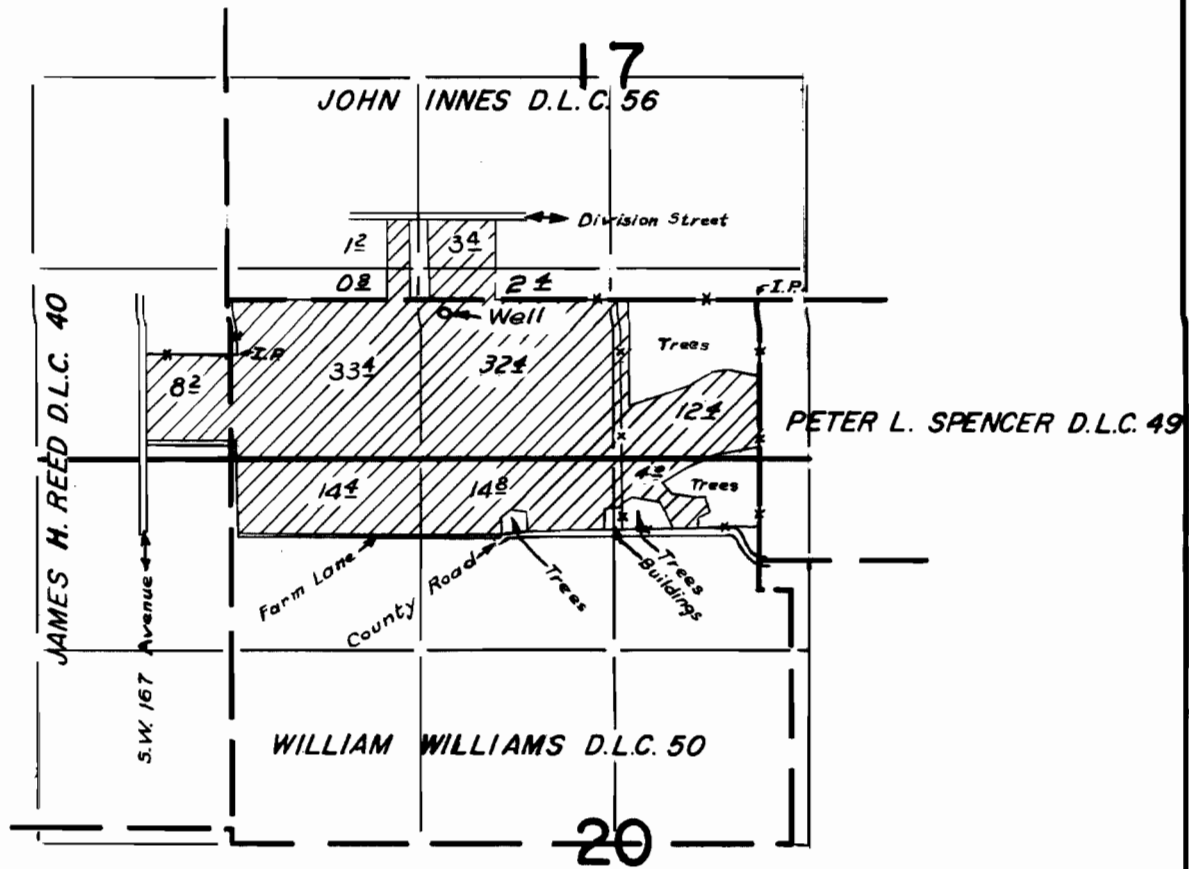

19

20

**FINAL PROOF SURVEY**  
UNDER

Application No. G-1351... Permit No. G-1229  
IN NAME OF

SCHUEPBACH Bros.

Surveyed May 24 1965, by M. Bish