


T.2S. R.2W. W.M.

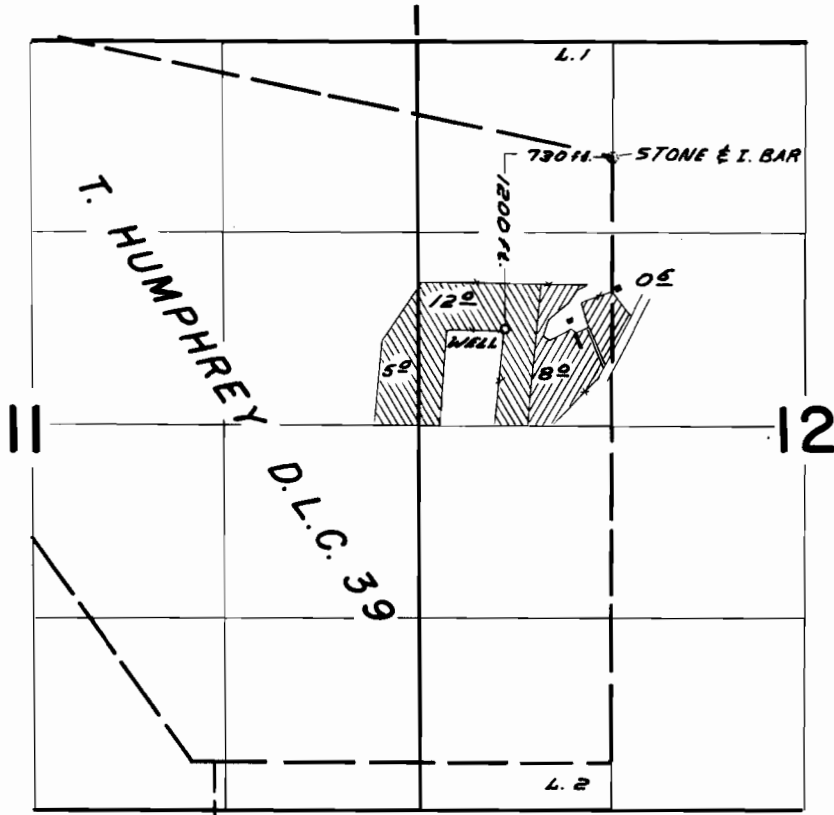

PRIMARY



SUPPLEMENTAL
TO CERT. No. 20132

FINAL PROOF SURVEY
UNDER

Application No. 6-2325 Permit No. 6-2150
IN NAME OF

J. H. ATEN

Surveyed MAY 28 1965, by M. BISH