


T.1&2N. R.2W. W.M.

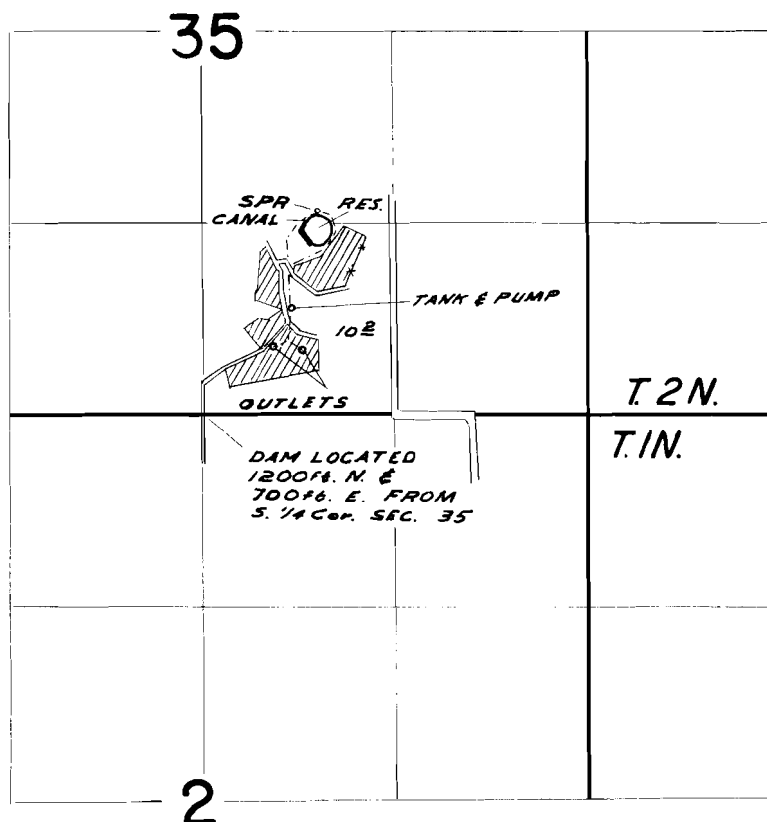

**FINAL PROOF SURVEY**  
UNDER

R-33540 R-2313  
Application No. 33541 Permit No. 26526  
IN NAME OF

GEORGE TEUFEL

Surveyed MAY 21 1965, by M. BISH