


T. 2S. R. 2W. W.M.

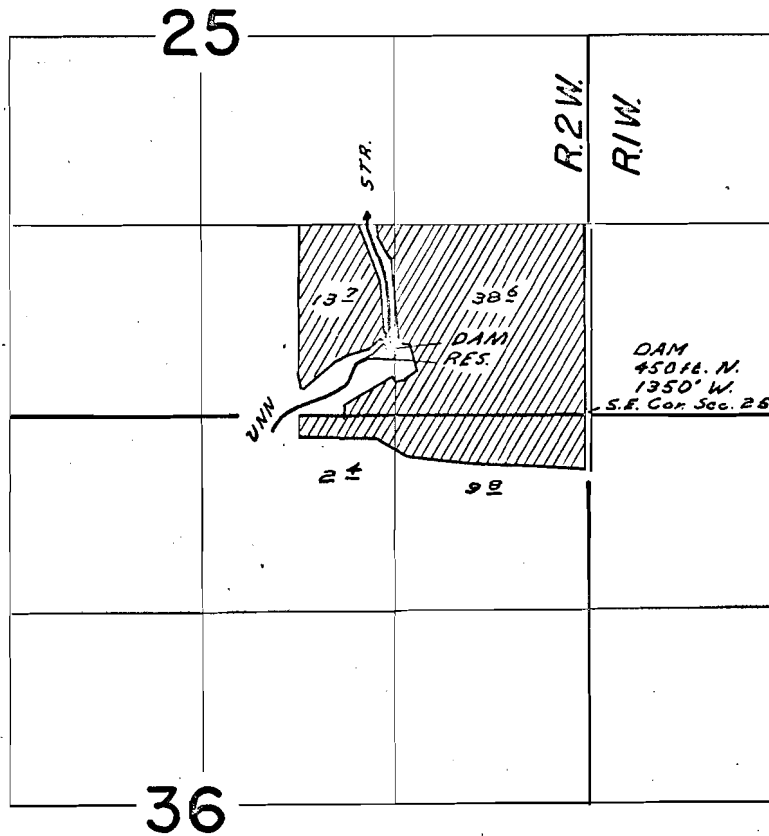

FINAL PROOF SURVEY
UNDER

R-34149

R-2459

Application No. 34150 Permit No. 26908
IN NAME OF

HERBERT ELWART

Surveyed MAY 7, 1965, by L. COLEBANK