


# T. 1N. R. 3W. W.M.

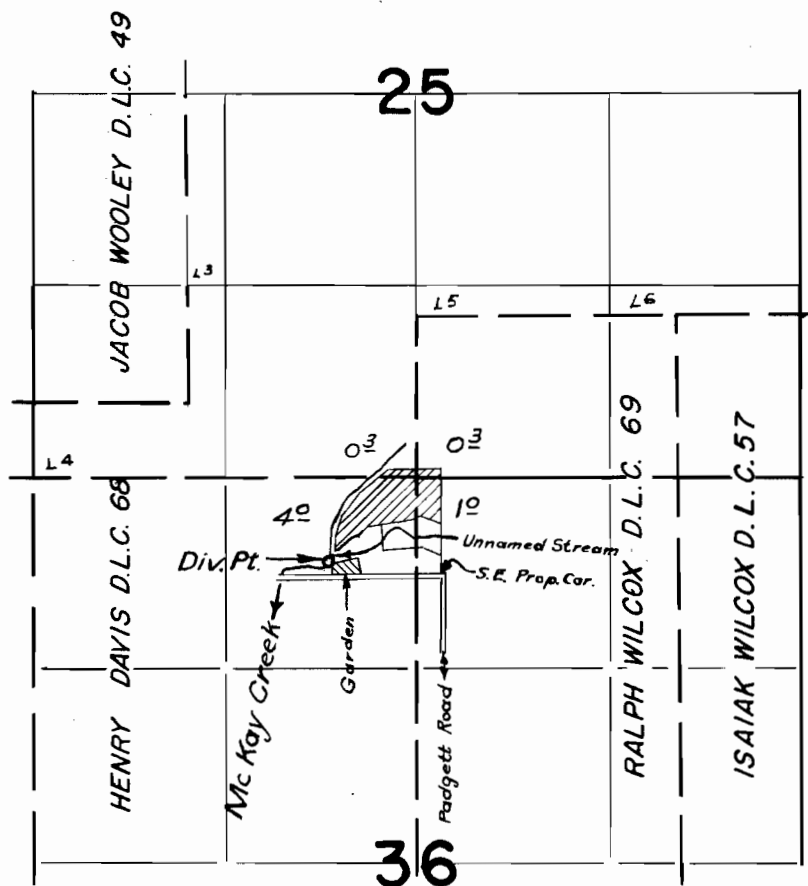

## FINAL PROOF SURVEY UNDER

Application No. 36592 Permit No. 27638  
IN NAME OF

BETTY LOU WALLENDER

Surveyed Dec. 26, 1962, by M. Bish  
May 21, 1965