


T.2S. R.1W. W.M.

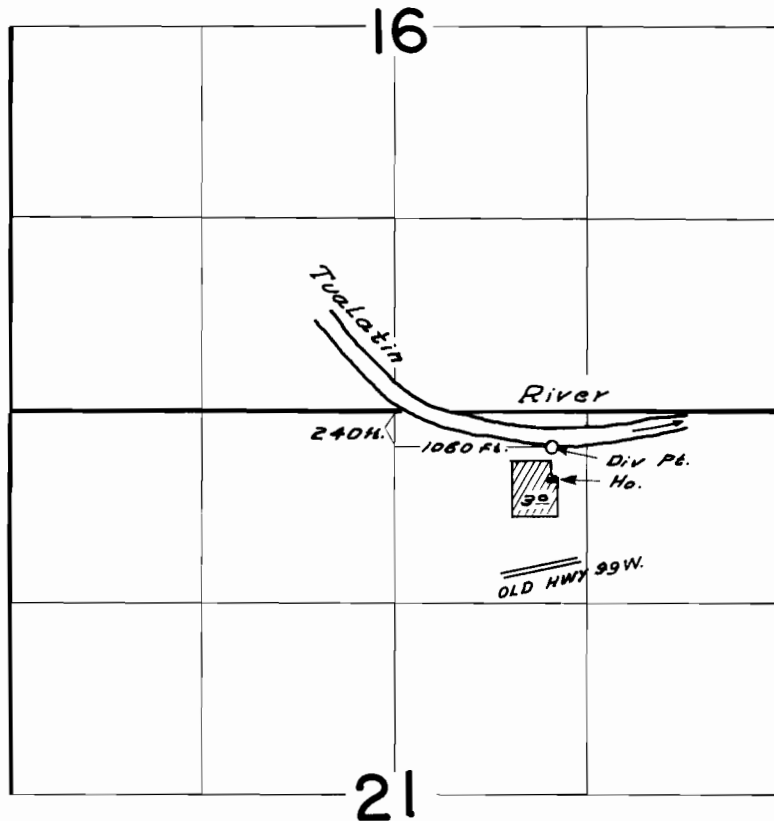

FINAL PROOF SURVEY
UNDER

Application No. **37949** Permit No. **28303**
IN NAME OF

LE ROY J. FAIST

Surveyed **MAY 6** 1965, by **L. COLEBANK**