


T.1S. R.2 W. W.M.

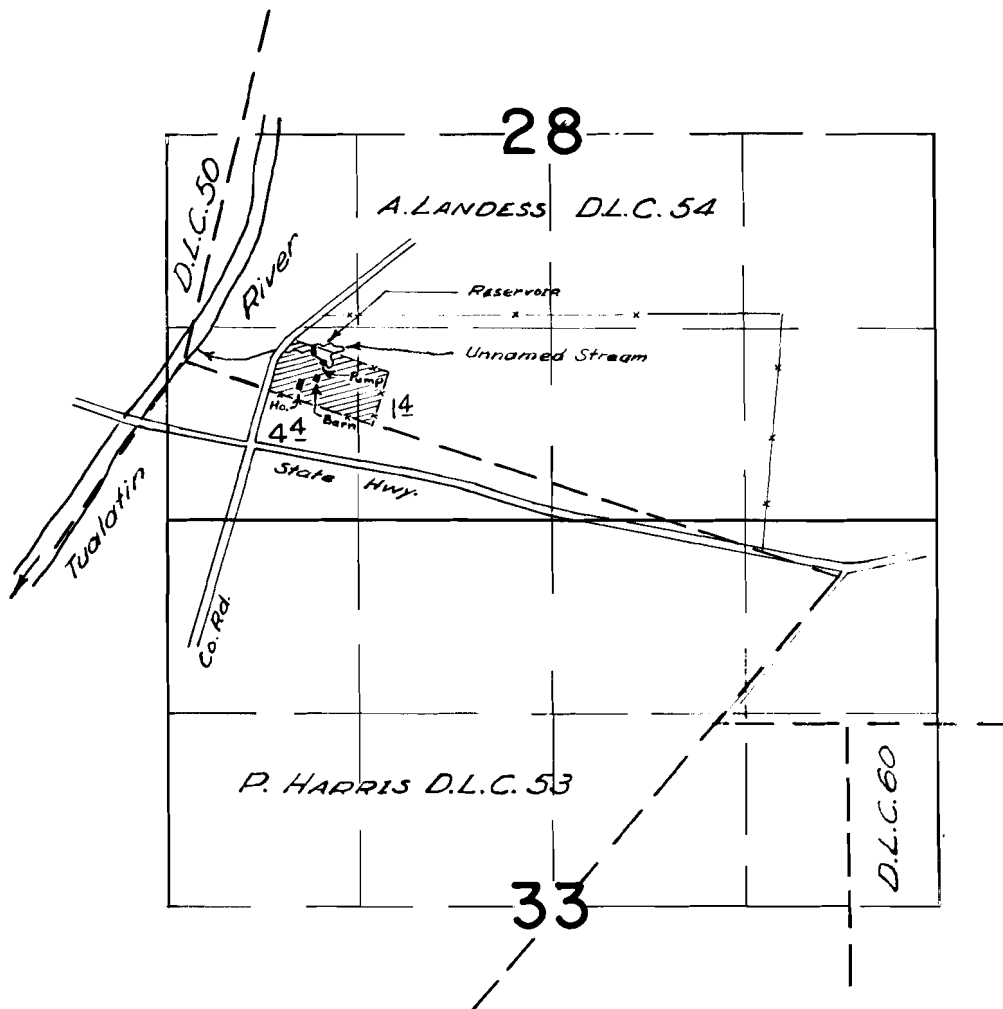

FINAL PROOF SURVEY
UNDER

Application No. ³⁷⁸⁹⁴ ~~R-37919~~ Permit No. ²⁸⁵⁵² ~~R-3203~~
IN NAME OF

JOHN L. & RITA M. WANDELL

Insp. June 25 1965
Surveyed Mar. 8 1963, by T. B. Bish