


T.2S. R.2W. W.M.

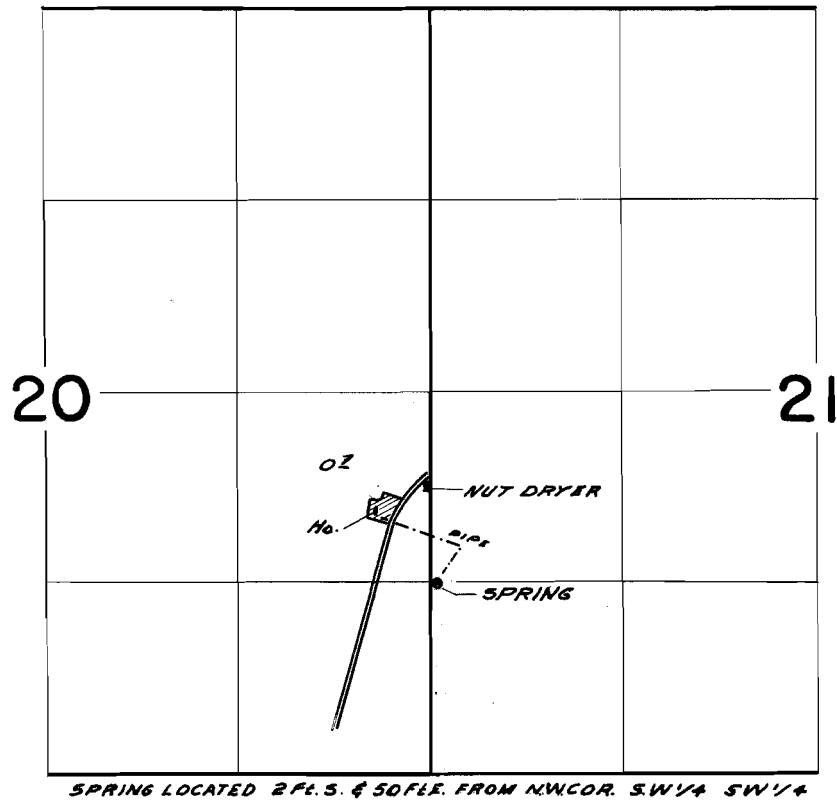

FINAL PROOF SURVEY
UNDER

Application No. 40173 Permit No. 29945
IN NAME OF

GEORGE C. & NADINE I. WENDLAND

Surveyed MAY 3 1965, by L. COLEBANK