


RECEIVED

NOV 30 1995

WATER RESOURCES DEPT
SALEM, OREGON

T.5S.R.3W.W.M.

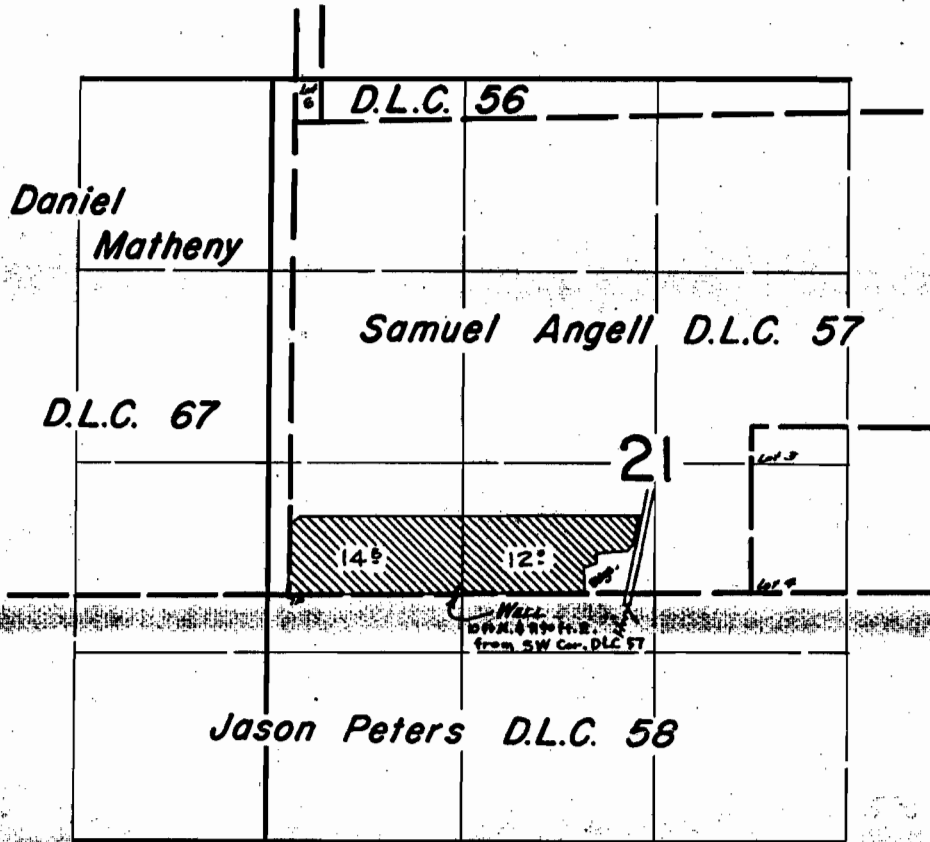

FINAL PROOF SURVEY
UNDER

Application No. 9-1915... Permit No. 9-1760...
IN NAME OF

EMMA M. & WALTER L. DORMAN

Surveyed August 5, 1964, by *Al Jackson*