


T.5S.R.4 & 5W.W.M.

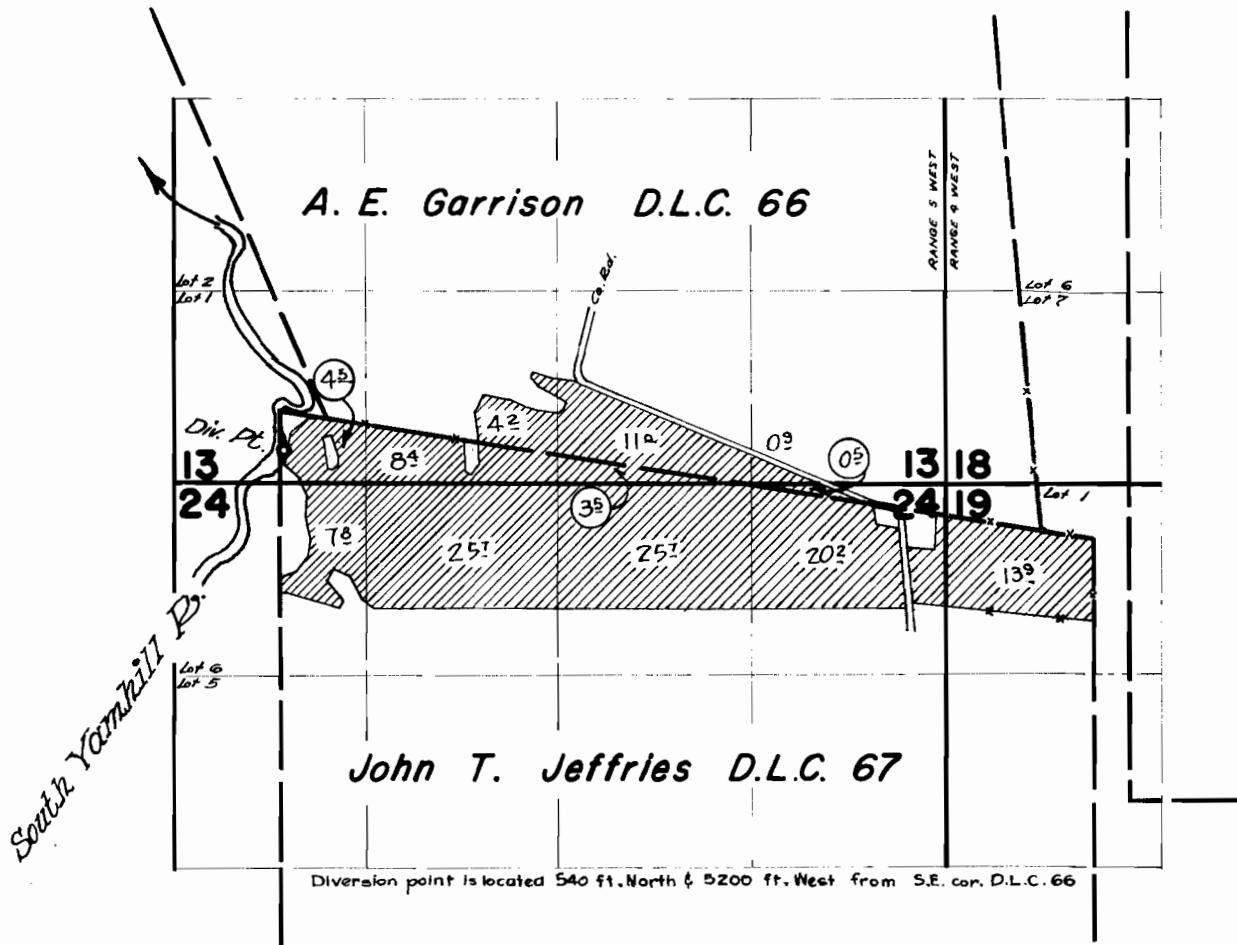

FINAL PROOF SURVEY
UNDER

Application No. 38558 .. Permit No. 28726 ..
IN NAME OF

MERRILL D. & ODELL S. OHLING

Surveyed August 7, 1964, by *[Signature]*