


26668  
31066  
33130

# T.33&34S.R.7½E.W.M.

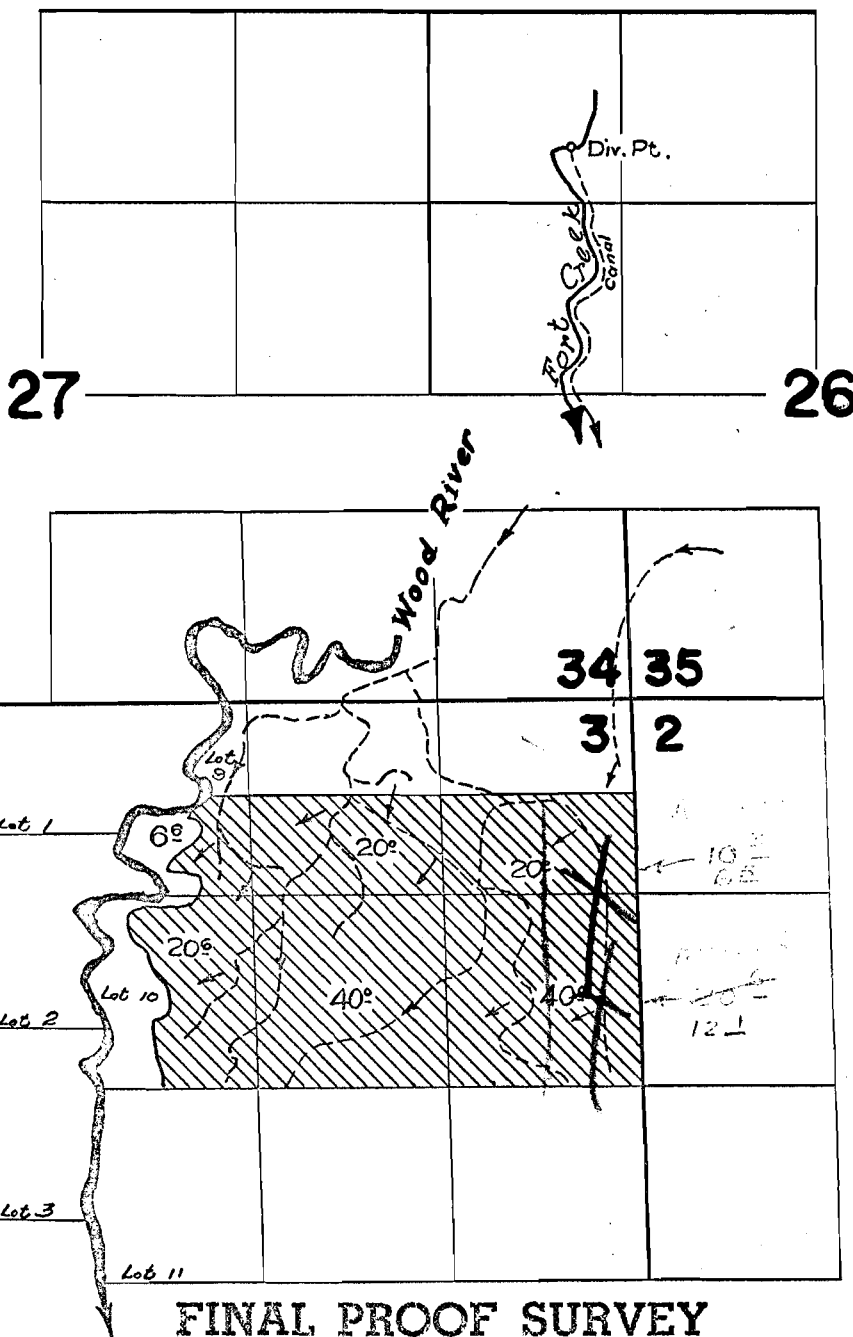

Checked C.W. & M.C.

see map  
# 29099

## FINAL PROOF SURVEY UNDER

Application No. 33779... Permit No. 26668  
IN NAME OF

J. L. & R. D. HELMS

Surveyed August 14 1962., by *R. Johnson*