


T.6S., R.43E.W.M.

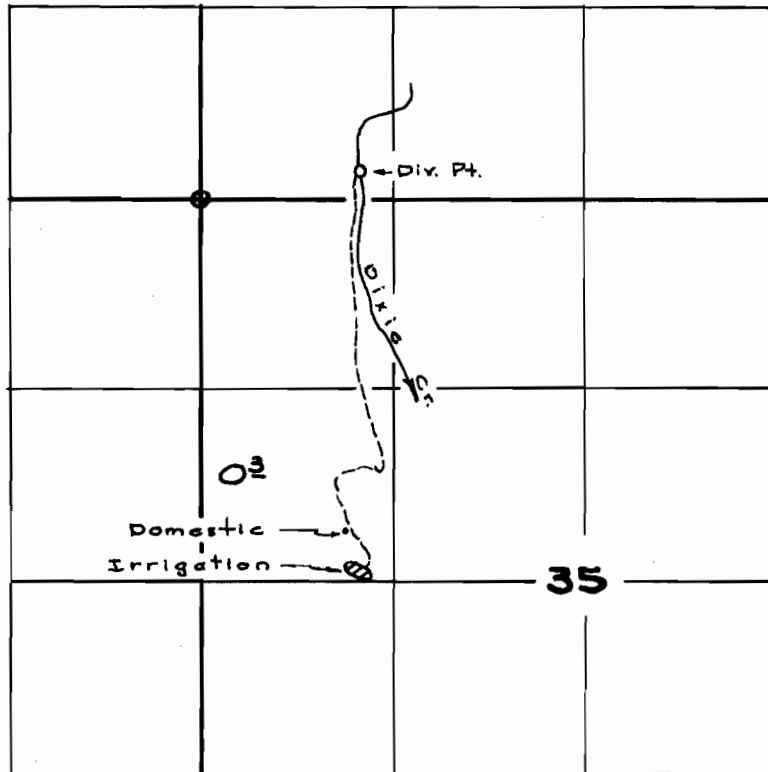

FINAL PROOF SURVEY
UNDER

Application No. 33158 Permit No. 26230
IN NAME OF

DONALD C. RIGGLE

Surveyed Oct. 20 1964, by D.B. Hall