


T.4S.R.1E.W.M.

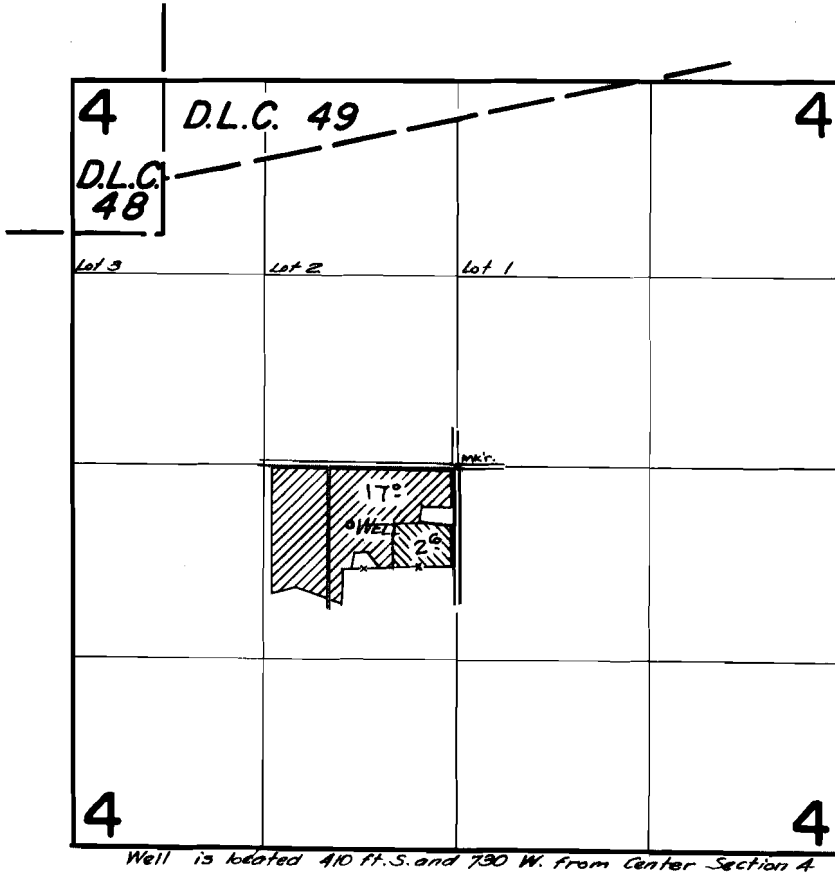

FINAL PROOF SURVEY UNDER

Application No. **G-2828** Permit No. **G-2631**
IN NAME OF

O. P. MONROE

Surveyed August 16 1965, by *[Signature]*