


T. 2 S. R. 4 E. W. M.

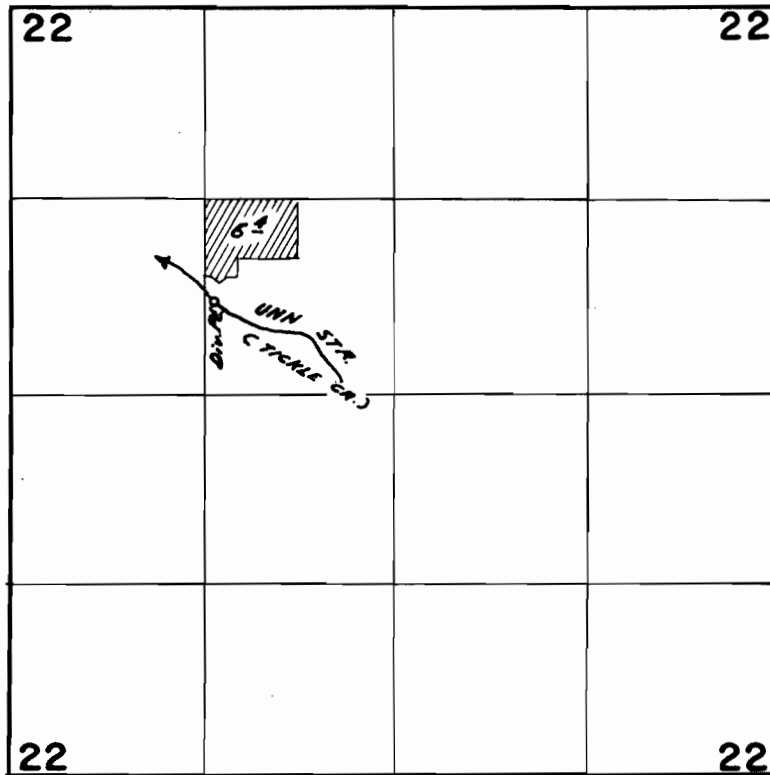

FINAL PROOF SURVEY
UNDER

Application No. 34687 Permit No. 27238
IN NAME OF

EDWARD J. KRAFT

Surveyed AUG 13 1964, by C. GARDNER