


# T.2S.R.6E.W.M.

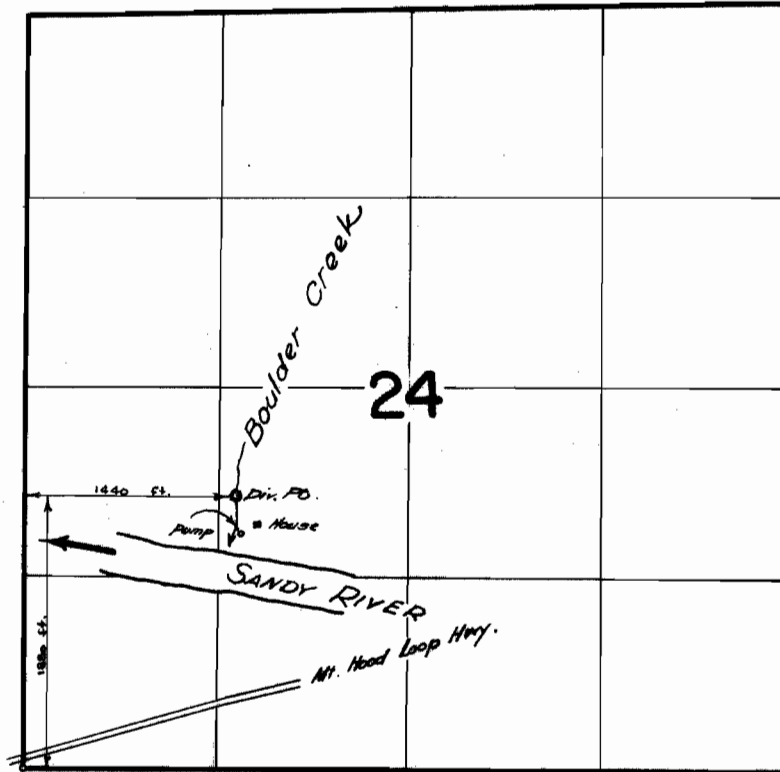

## FINAL PROOF SURVEY UNDER

Application No. 35106 Permit No. 27635  
IN NAME OF

ERNEST C. HEFFNER

Surveyed July 31, 1963, by T. Lauer  
May 10, 1965, by R. Jackson