


T.4N.R.10W.W.M.

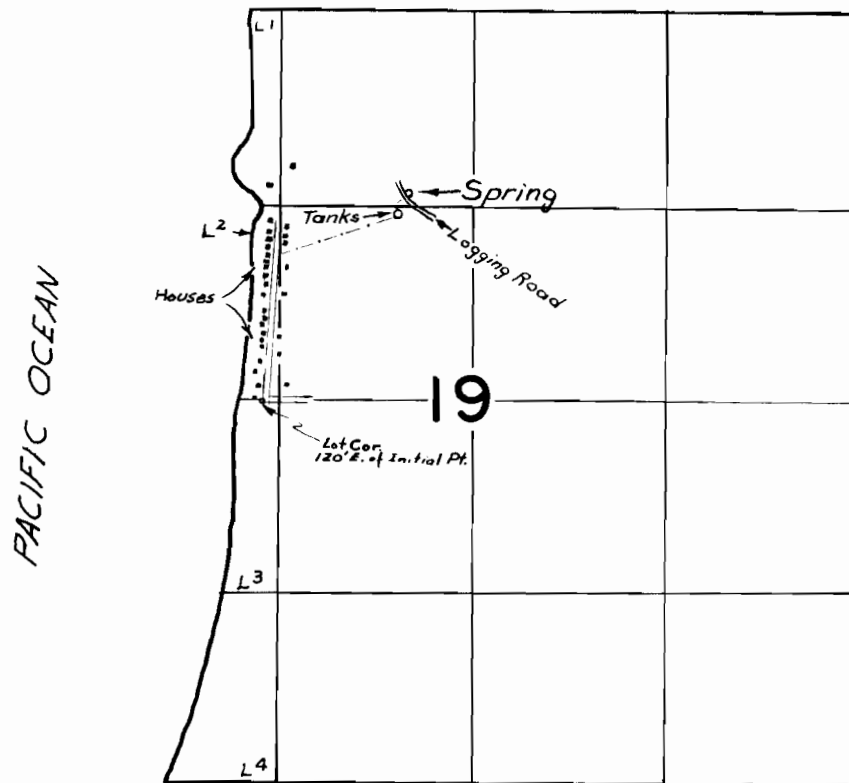

FINAL PROOF SURVEY
UNDER

Application No. 21896 Permit No. 17241
IN NAME OF

WESTERN SHOREWAYS, INC.

Surveyed May 19 1964, by M. Bish