


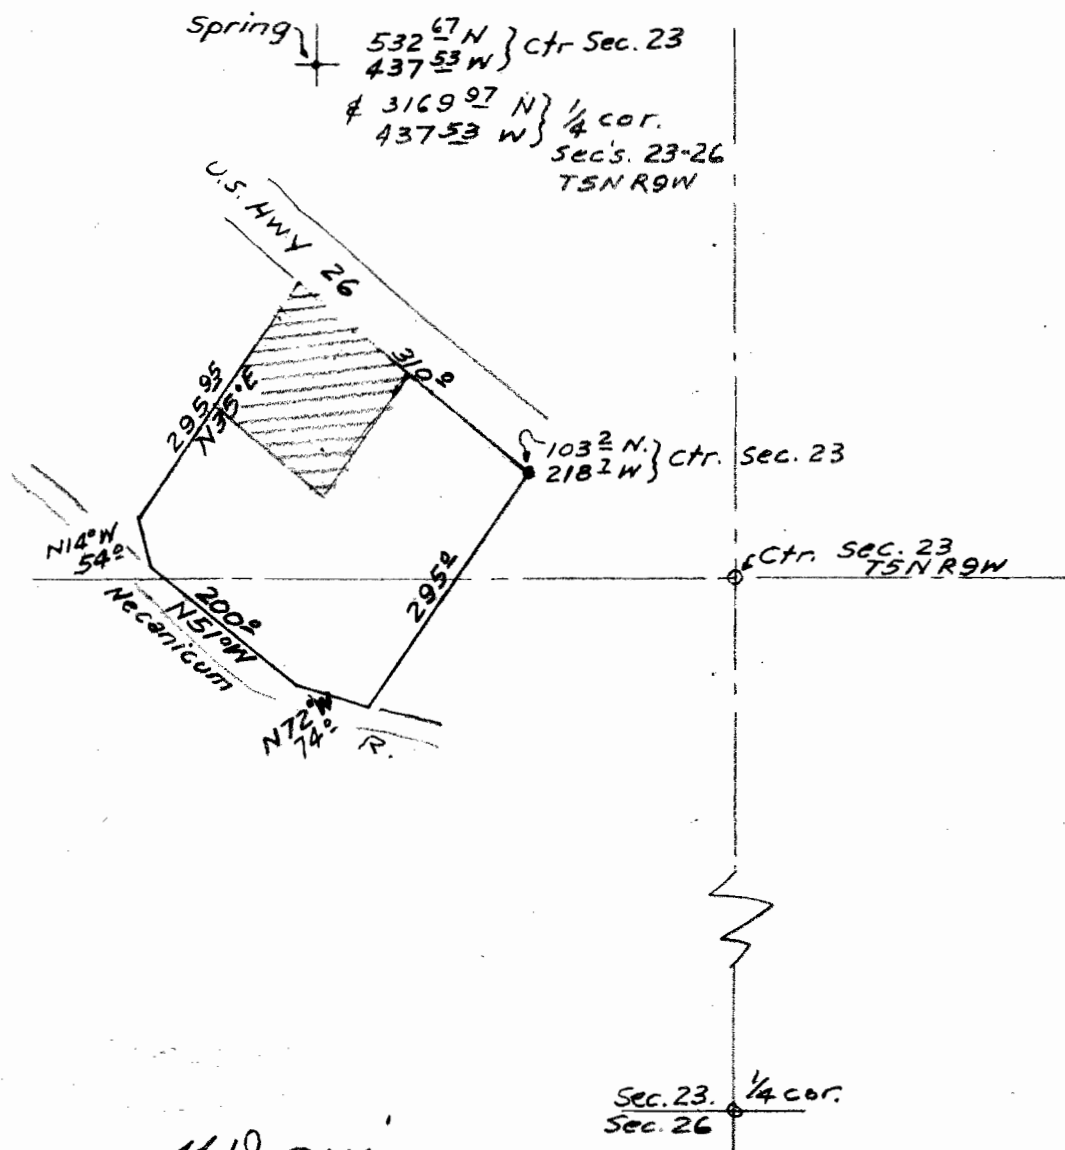

Weldon Y Davis

LESTER ORDWAY PROP.
 Scale 1" = 200' Dec. 20, 1956

Application No. 30935
 Permit No. 24538