


T.8N.R.8W.W.M.

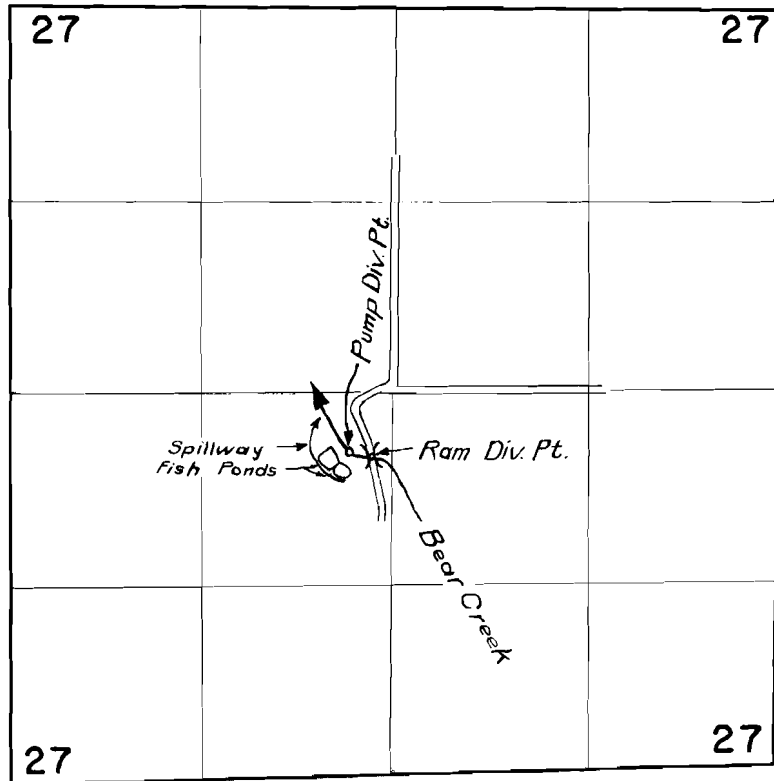

FINAL PROOF SURVEY
UNDER

R-34182 R-2585
Application No. 33984 Permit No. 27185
IN NAME OF

REUBEN A. MATTSON

Surveyed May 21, 1964, by M. Bish