


T. 4N.R.7W.W.M.

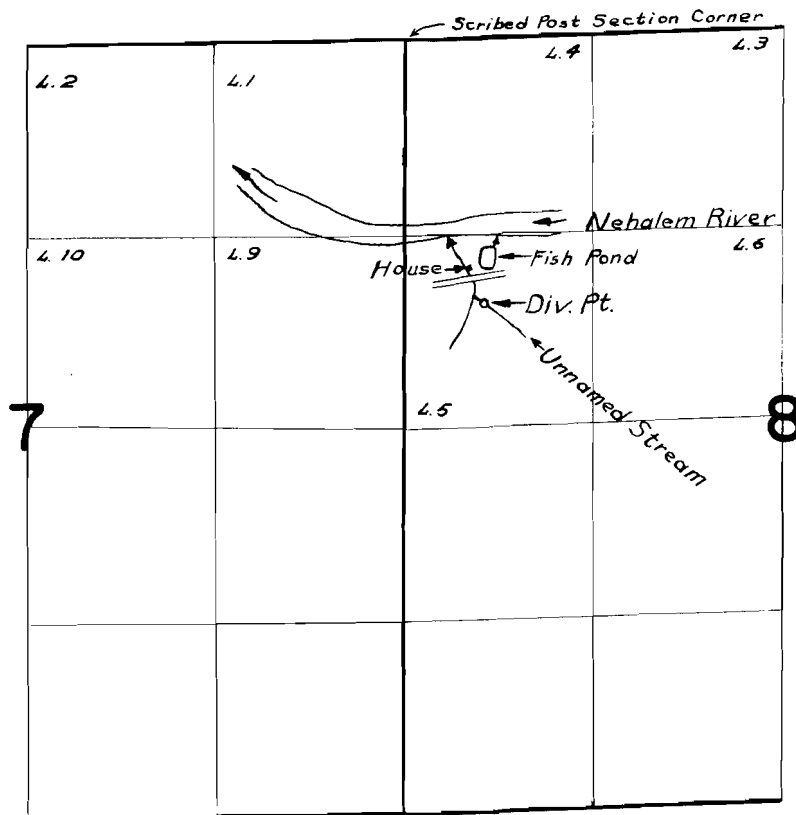

FINAL PROOF SURVEY
UNDER

R-37895

R-3090

Application No. 37896 Permit No. 28238
IN NAME OF

J.R. WILLIS and CORA W. WILLIS

Surveyed May 18 1964, by M. Bish.

1964-1A

L. L. Jr.