


T.4N.R.10W.W.M.

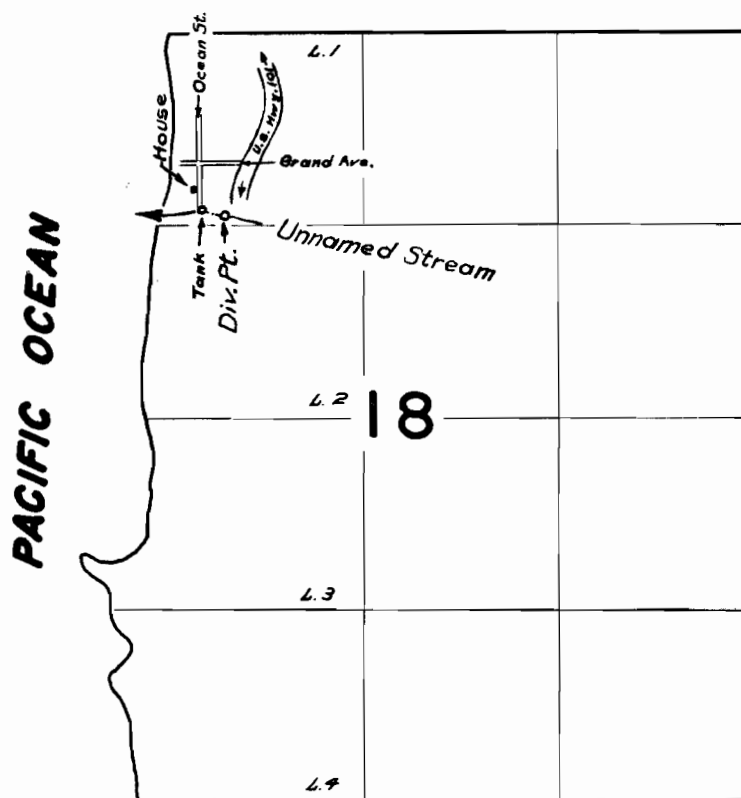

FINAL PROOF SURVEY
UNDER

Application No. 38409 Permit No. 28608
IN NAME OF

DARRELL and JEANNE MOORE

Surveyed May 19 1964, by M. Bish

1964-1A

S. L. J.