


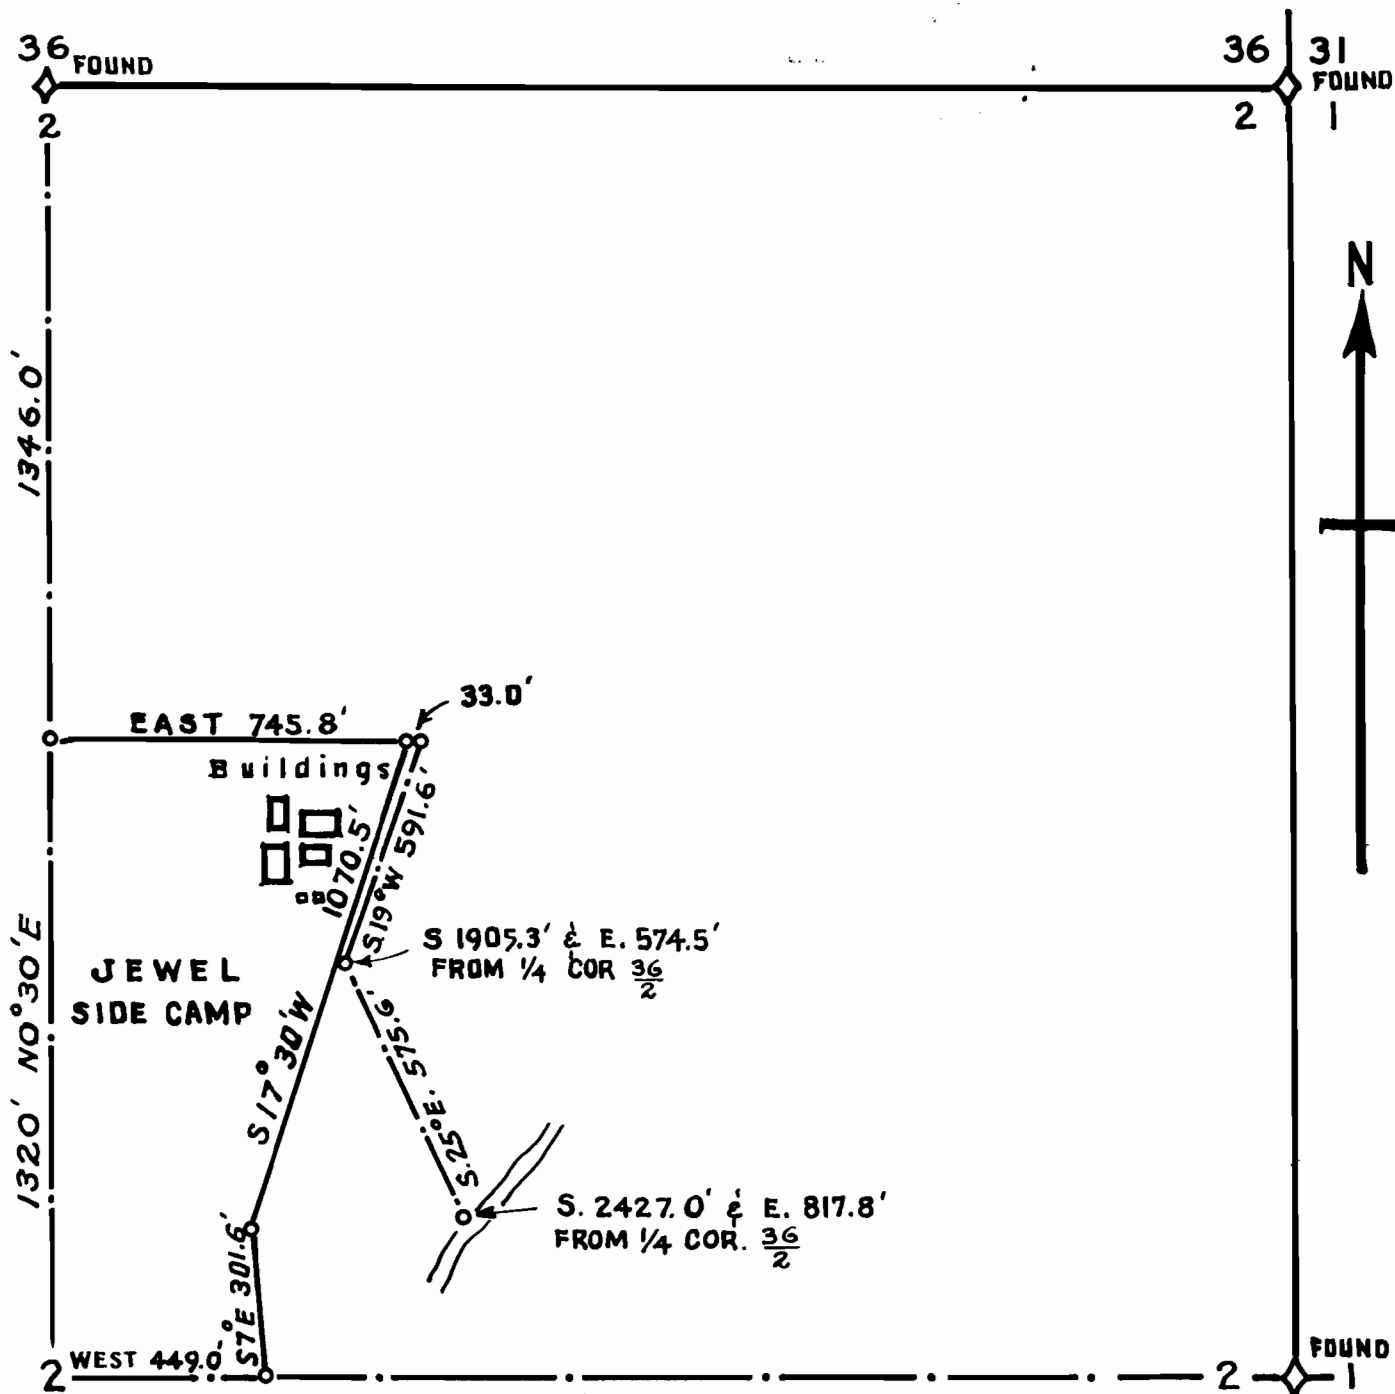

SURVEY FOR:
STATE OF OREGON-DEPARTMENT OF FORESTRY
JEWELL SIDE CAMP
PIPELINE RIGHT OF WAY
NE 1/4 SEC. 2 T. 5 N. R. 7 W. W. M
CLATSOP COUNTY, OREGON

COMPASS & CHAIN SURVEY BY: L.W. AMORT FEB. 1960
SCALE: 1" = 400'
F. SARGENT
D. RUST



AE-9

TR. 4-5-63 H. W. AVES