


T. 3N. R. 2W. W.M.

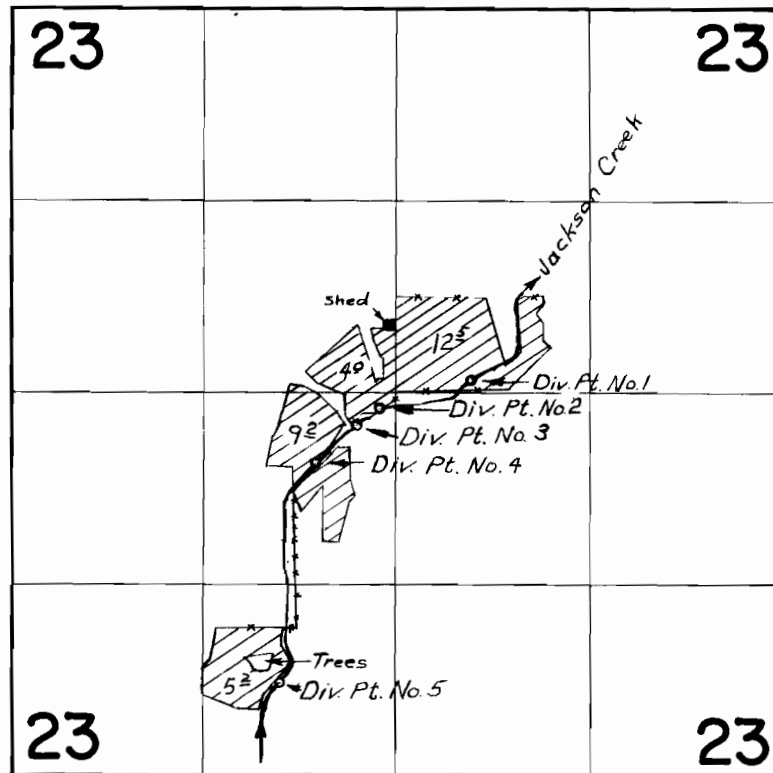

FINAL PROOF SURVEY
UNDER

Application No. 32575 Permit No. 25611
IN NAME OF

ARNOLD F. and BEATRICE W. SATT LER

Surveyed Oct. 8 1964, by M. Bish