


T.3N. R.2W. W. M.

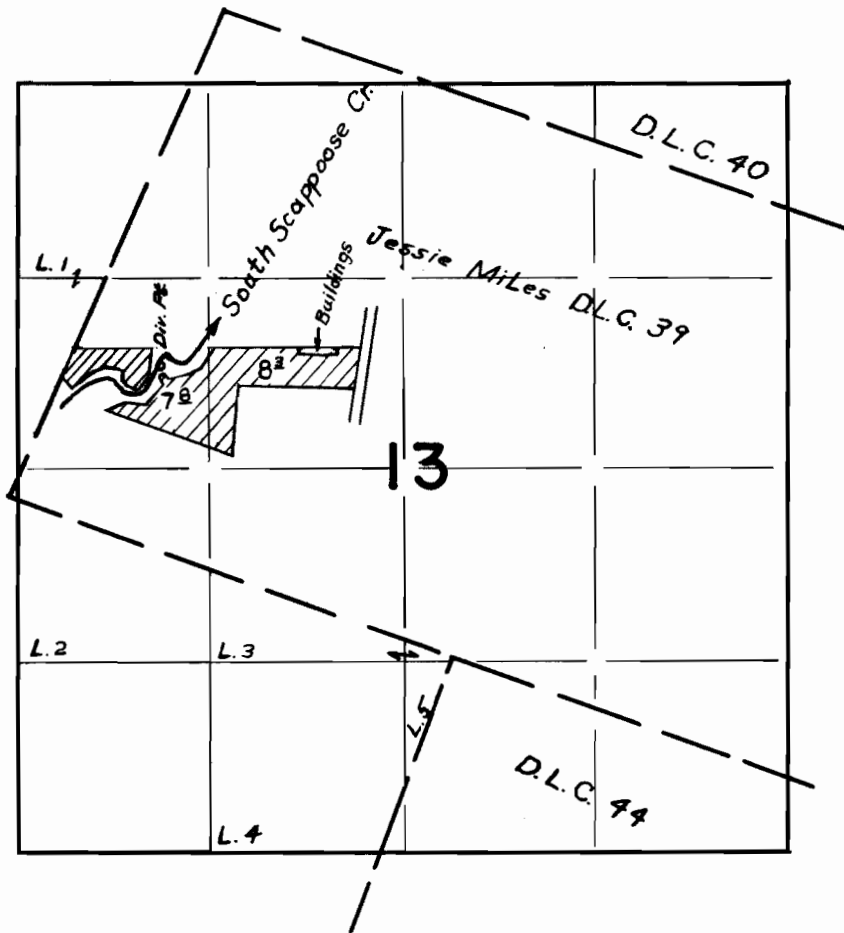

**FINAL PROOF SURVEY**  
UNDER

Application No. 33830. Permit No. 26673.  
IN NAME OF

JOSEPH C. BARTA

Surveyed Oct. 2 1964, by M. Bish  
APR. 1 66 M. Bish

1965-A  
1964-1B

*S. L. J.*