


T.5N. R.4W. W.M.

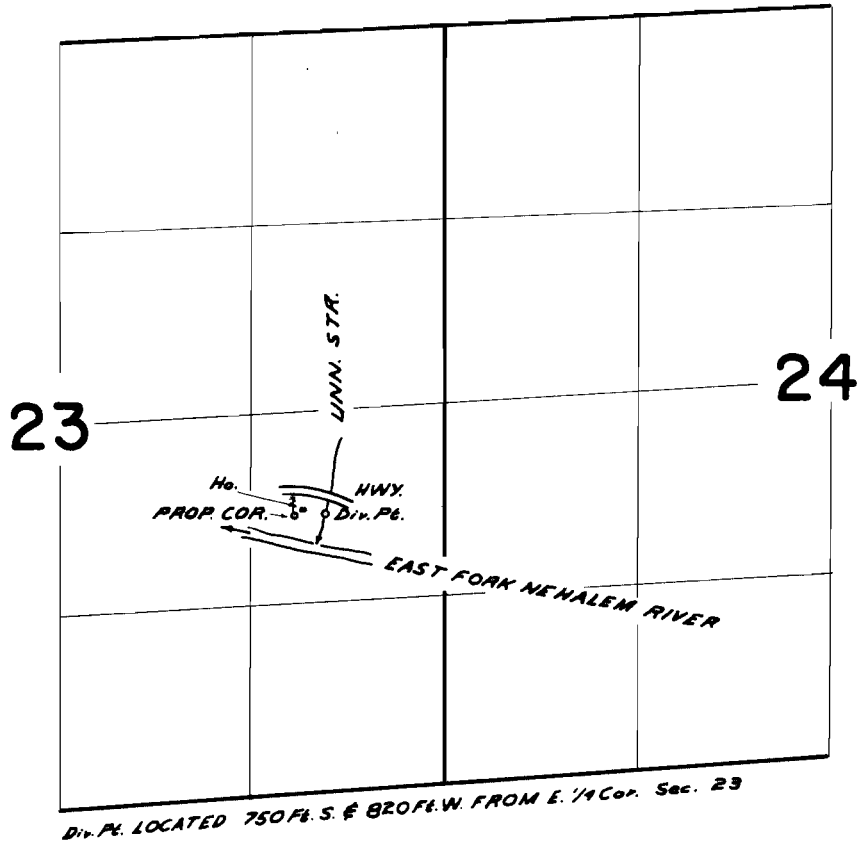

FINAL PROOF SURVEY
UNDER

Application No. 34202 Permit No. 26947
IN NAME OF

ANNIE LEAH ROBERTS

Surveyed OCT 7 1964, by M. BISH