


T. 4N. R. 2W. W. M.

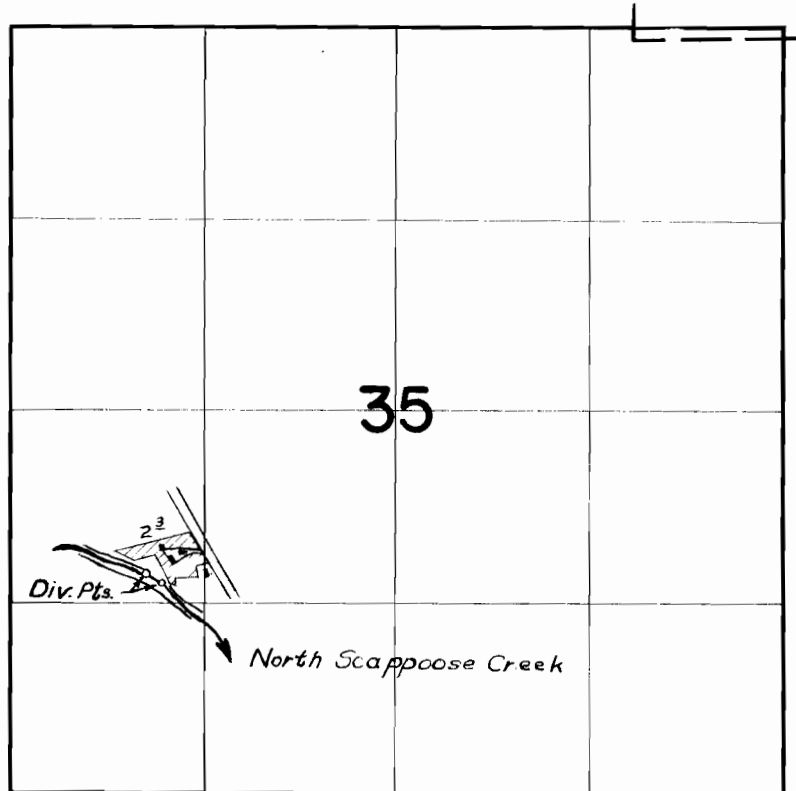

FINAL PROOF SURVEY
UNDER

Application No. 37237 Permit No. 27752
IN NAME OF

MC KEE A. SMITH

Surveyed Oct. 2 1964, by M. Bish