


# T.13S. R.29E.W.M.

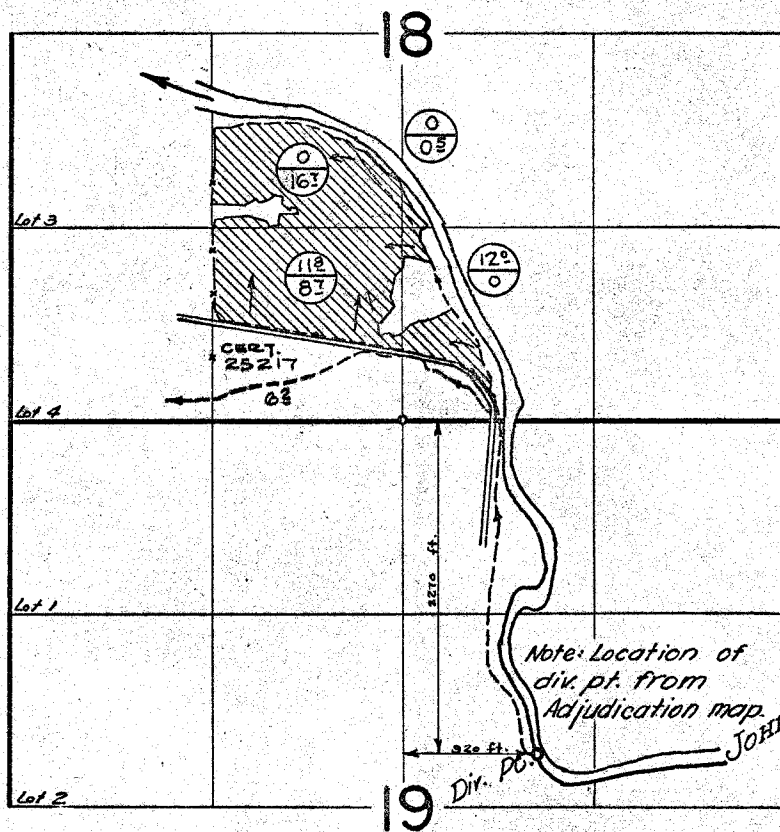

⊖ Acreage under Cert. 25217  
 ⊕ Acreage under Permit 26738

## FINAL PROOF SURVEY UNDER

Application No. 33749 Permit No. 26738  
 IN NAME OF

KATHERINE GEISLER

Surveyed Oct. 23, 1964, by *L. Jackson*